

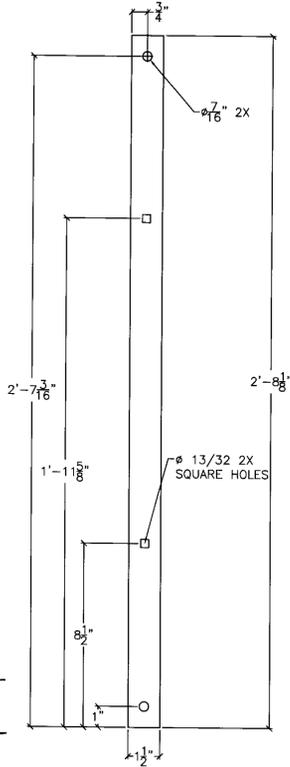
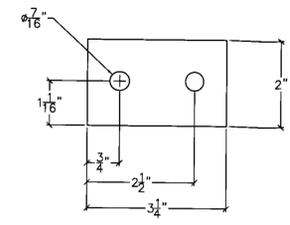


RAILING SYSTEM:

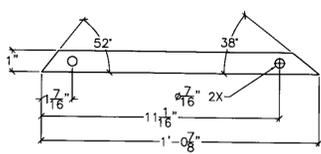

HR05: PLATE-1/4"
6" = 1'-0" QTY. 48

HR08: PLATE-1/4"
1'-0" = 1'-0" QTY. 12

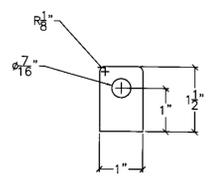

W01: PLATE-1/4"
1'-0" = 1'-0" QTY. 775

RECEIVED
 OK'D BY _____
 JUL 3 12
 BY *W.P.S.* DATE 8/6/09

HR09: PLATE-1/4"
6" = 1'-0" QTY. 24

Revised Plot Construction For Paper Plot Only (802) 257-7383	
TITLE: Wallingford Bridge Rehab LOCATION: Wallingford, VT	DRAWING TITLE: Drawings Railing System Drawings DRAWN BY: JED CHECKED BY: JED/AS
DRAWING NO: R-1	JOB CONTACT: Erick Foster State of VT DATE: 4-30-09
SHEET NO: 5 of 10	