




RAILING SYSTEM: FLARED END LEFT

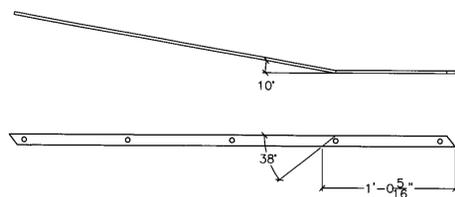


HRO21: LATTICE (USE HRO2)
3" = 1'-0" QTY 2

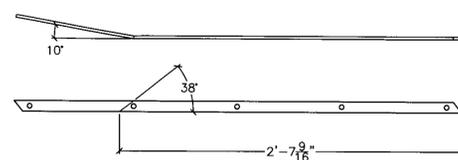

HRO22: LATTICE (USE HRO2)
3" = 1'-0" QTY 2

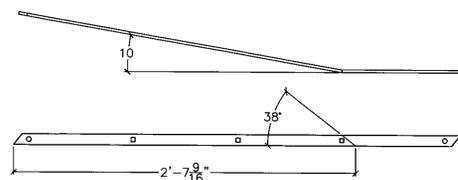

HRO11: -LATTICE(USE HRO1)
3" = 1'-0" QTY 2

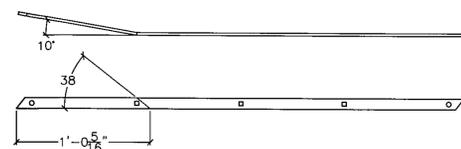

HRO12 -LATTICE (USE HRO1)
3" = 1'-0" QTY 2

RECEIVED
 CK'D BY _____ OK'D BY _____
 JUL 31 2009
 BY *WYB SJ* DATE *8/1/09*

Revised Base Construction Revised for (802) 257-7383	
TITLE: Wallingford Bridge Rehab LOCATION: Wallingford, VT	DRAWING NO: R-1
DRAWING TITLE: Drawings Railing System Drawings DRAWN BY: sed CHECKED BY: ED/AD	JOB CONTACT: Erick Foster State of VT DATE: 4 30 09
SHEET NO: 7 OF 10	