




RAILING SYSTEM: FLARED END RIGHT

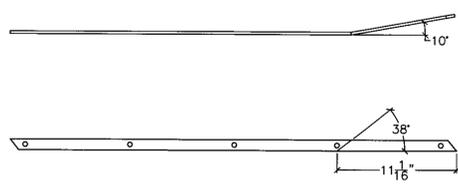


HRO23; LATTICE (USE HRO2)
 3" = 1'-0" QTY 2

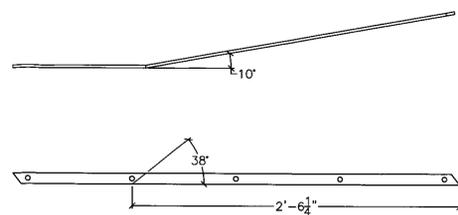

HRO24; LATTICE (USE HRO2)
 3" = 1'-0" QTY 2

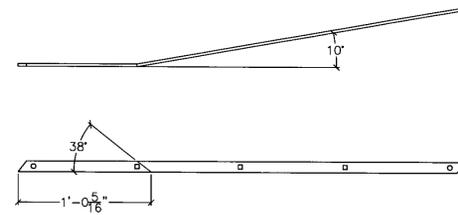

HRO13; LATTICE (USE HRO1)
 3" = 1'-0" QTY 2

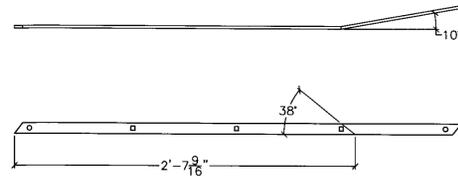

HRO14; LATTICE (USE HRO1)
 3" = 1'-0" QTY 2

RECEIVED
 OK'D BY _____ OK'D BY _____
 JUL 31 2009
 BY *wyb* DATE 8/6/09

Penland Bros. Construction Penland Bros. Construction (802) 257-7333	
TITLE: Wallingford Bridge Rehab LOCATION: Wallingford, VT	DRAWING NO: R-1 SHEET NO: 8 OF 10
DRAWING TITLE: Drawings Rolling System Drawings DRAWN BY: JED CHECKED BY: JED/AD	JOB CONTACT: Erect Feater State of VT DATE: 4 30 09