



RAILING SYSTEM:

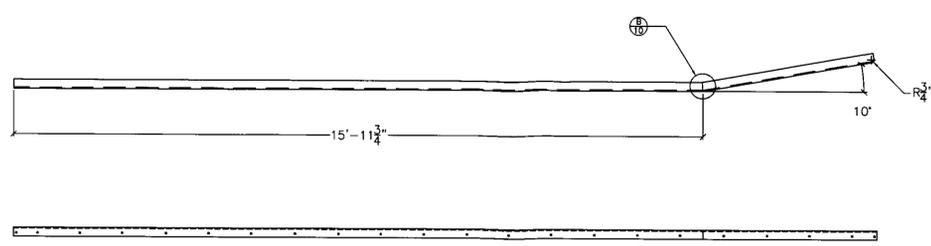


HR082, HR092: -ANGLE (USE HR07)
 1" = 1'-0" QTY 4

NOTES

- *RELIEF CUT TO BE MADE IN ANGLE, THEN BENT AND WELDED
- *BENDS TO BE PERFORMED COLD, ON A PRESS BRAKE

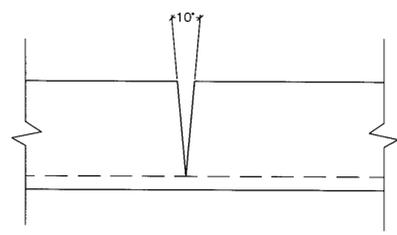

RELIEF CUT DETAIL
 1'-0" = 1'-0"

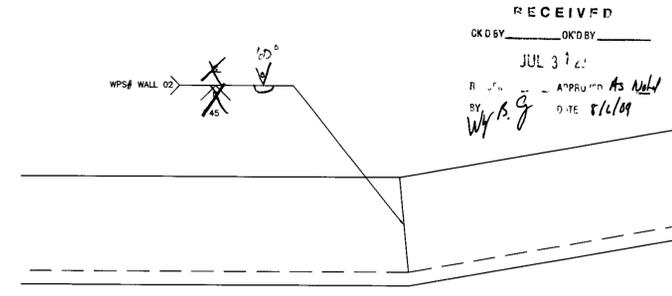

B
 10 WELD DETAIL AT FLARE
 1" = 1'

RECEIVED
 OK'D BY _____ OK'D BY _____
 JUL 3 2009
 BY *W.H.B.G.* DATE *8/2/09*

| | |
|--|-----------------------------|
| Revised Eros Construction 1000 Main Street Wallingford, VT 05491 (802) 257-7283 | |
| TITLE Wallingford Bridge Rehab | LOCATION Wallingford, VT |
| DRAWING TITLE Drawings Railing System Drawings | DRAWN BY JED |
| CHECKED BY JED/AD | DATE 4 30 09 |
| DRAWING NO. R-1 | SHEET NO. 10 of 10 |