

SEE SHEET 2 FOR INDEX OF SHEETS

STATE OF VERMONT AGENCY OF TRANSPORTATION





PROPOSED IMPROVEMENT BRIDGE PROJECT TOWN OF WALLINGFORD COUNTY OF RUTLAND

ROUTE NO : PEDESTRIAN BRIDGE BRIDGE NO : ADAPTIVE REUSE

PROJECT LOCATION: LOCATED IN THE COUNTY OF RUTLAND, TOWN OF WALLINGFORD,
PEDESTRIAN BRIDGE OVER THE OTTER CREEK, APPROXIMATELY 800+/- FEET
SOUTH OF VT. ROUTE 140 BETWEEN WALDO LANE AND THE WALLINGFORD TOWN PARK.

PROJECT DESCRIPTION: REHABILITATE AND ASSEMBLE HISTORIC TRUSS OVER OTTER CREEK AT THE WALLINGFORD TOWN PARK.

LENGTH OF STRUCTURE : 120.91 FEET
LENGTH OF APPROACH: 154.01 FEET
LENGTH OF PROJECT: 274.92 FEET

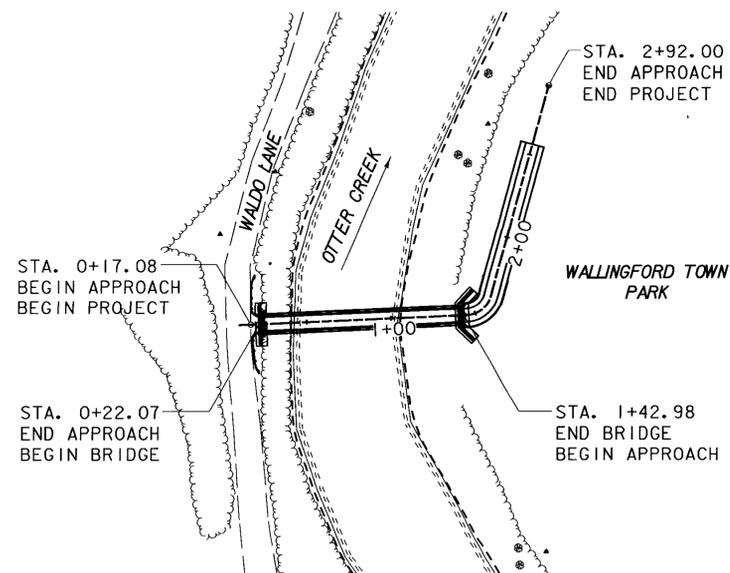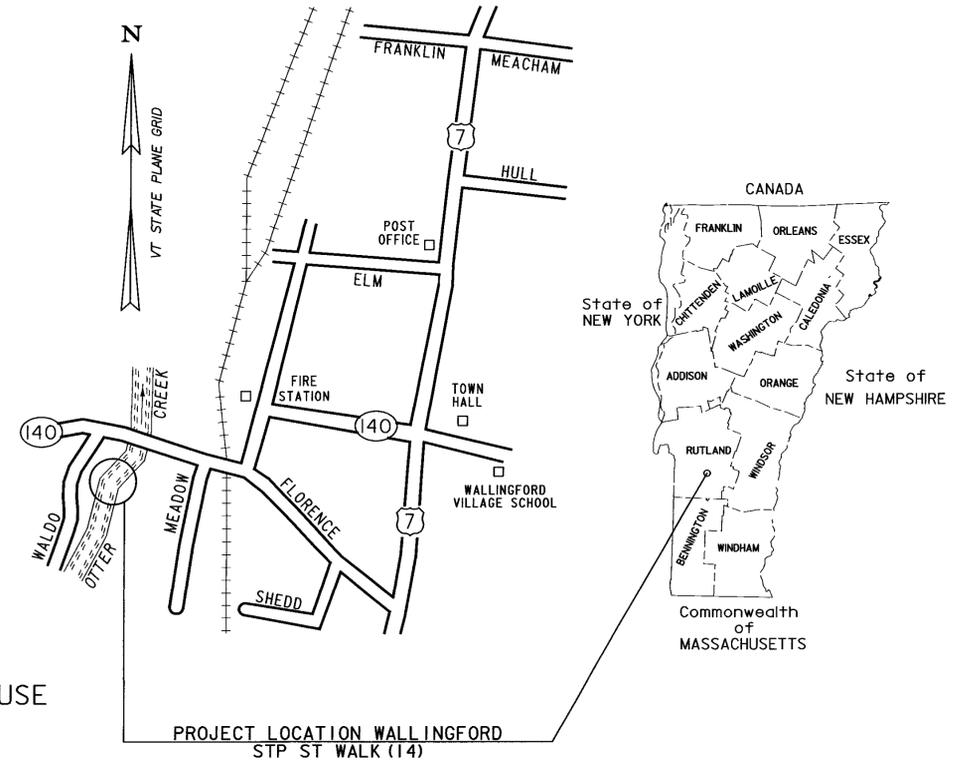

SCALE 1" = 50'
50 0 50

RECORD PLANS	
CONTRACTOR	RENAUD BROTHERS, INC - VERNON, VT
RESIDENT ENGINEER	ERIC FOSTER
CONSTRUCTION BEGAN	APRIL 10, 2009
CONSTRUCTION COMPLETE	NOVEMBER 18, 2009
RECORD PLANS BY	ERIC FOSTER & NICK GARBACIK
I HEREBY CERTIFY THAT ALL THE CONSTRUCTION REQUIRED BY THIS SET OF DRAWINGS HAS BEEN ACCOMPLISHED AS INDICATED HEREIN	
BY	<i>Eric Foster</i> RESIDENT ENGINEER
DATE	10 25 2010
NOTE: Any further information concerning final quantities, amounts or other details relative to this project may be found at Central Files in the electronic archives (OnBase)	

CONVENTIONAL SYMBOLS	
COUNTY LINE	
TOWN LINE	
LIMITS OF ACCESS	
POINT OF ACCESS	
FENCE LINE	
STONE WALL	
TRAVELED WAY	
GUARD RAIL	
RAILROAD	
SURVEY LINE	
CULVERT	
POWER POLE	
TELEPHONE POLE	
TREES	
CONTROL OF ACCESS	
PROPERTY LINE	
R.O.W. TAKING LINE	
SLOPE RIGHTS	
TOP OF CUT	
TOE OF SLOPE	



PLANS PREPARED BY
Richard A. Bruce



DATUM
VERTICAL NAVD 88
HORIZONTAL NAD 83 (92)

THESE PLANS ARE SUBJECT TO SUCH ENGINEERING CHANGES AS MAY BE REQUIRED BY THE FEDERAL HIGHWAY ADMINISTRATION OR THE DIRECTOR OF PROGRAM DEVELOPMENT.
CONSTRUCTION IS TO BE CARRIED ON IN ACCORDANCE WITH THESE PLANS AND THE STANDARD SPECIFICATIONS FOR CONSTRUCTION DATED 2006, AS APPROVED BY THE FEDERAL HIGHWAY ADMINISTRATION ON JUNE 15, 2006 FOR USE ON THIS PROJECT, INCLUDING ALL SUBSEQUENT REVISIONS AND SUCH REVISED SPECIFICATIONS AND SPECIAL PROVISIONS AS ARE INCORPORATED IN THESE PLANS.

DIRECTOR OF PROGRAM DEVELOPMENT	
APPROVED	<i>Richard A. Bruce</i> DATE 1-13-09
PROJECT MANAGER : SUSAN SCRIBNER	
PROJECT NAME : WALLINGFORD	
PROJECT NUMBER : STP ST WALK (14)	
SHEET 1 OF 26 SHEETS	