



TYPICAL BRIDGE SECTION

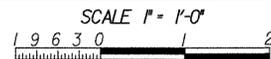


**NOTE:**

SEE STRUCTURAL STEEL AND TRUSS REHABILITATION NOTES ON SHT.13 FOR PAYMENT INFORMATION ON STRUCTURAL STEEL SURFACE PREPARATION AND PAINTING ITEMS.

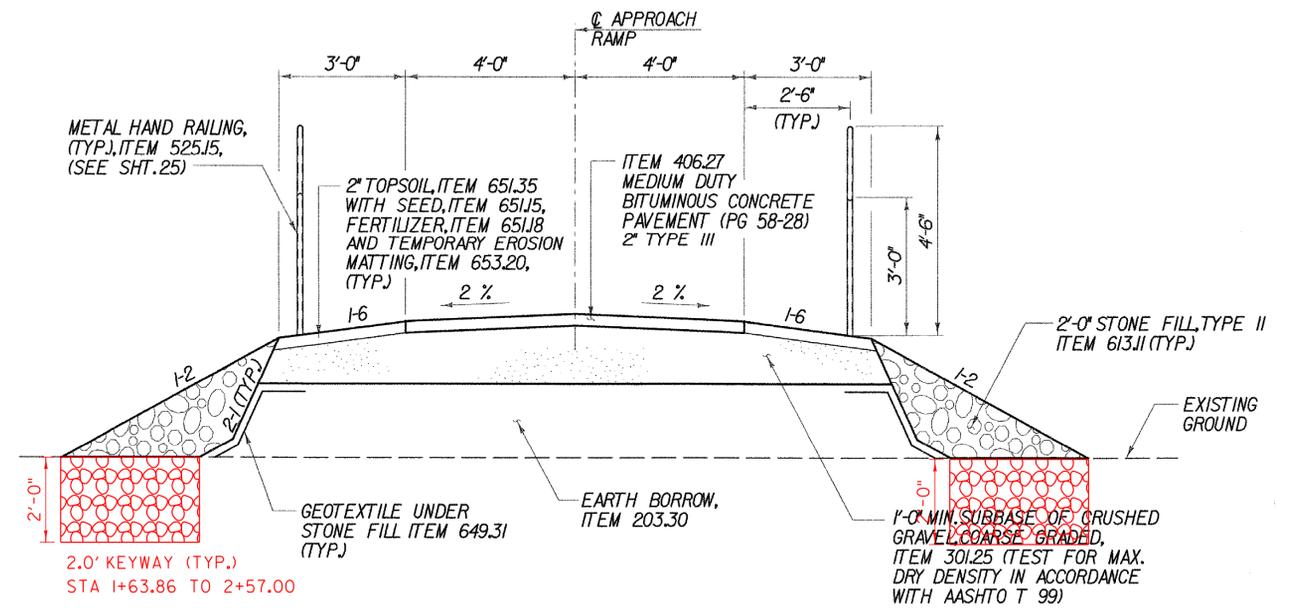

TYPICAL APPROACH RAMP SECTION

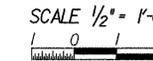

**SEEDING FORMULA  
RURAL AREAS**

% WT.	LBS./A.	NAME	PUR %	GERM %
37.5	22.5	CREeping RED FESCUE	98	85
37.5	22.5	TALL FESCUE	95	90
5.0	3.0	RED TOP	95	90
15.0	9.0	BIRDSFOOT TREFOIL	98	85
5.0	3.0	ANNUAL RYEGRASS	95	85
100.0	60.0			

**GENERAL NOTES**

SEED MIXTURE: SHALL NOT HAVE A WEED CONTENT EXCEEDING 0.40% BY WEIGHT AND SHALL BE FREE OF ALL NOXIOUS SEED.

SEED: TO BE APPLIED PER SEEDING FORMULAS OR AS DIRECTED BY THE RESIDENT ENGINEER.

FERTILIZER: FORMULA 10-20-10 TO BE USED WITH SEED APPLIED AT THE RATE OF 500 LBS./ACRE (HYDRO SEEDERS MAY USE 19-19-19 FORMULA).

AGRICULTURAL LIMESTONE: TO BE APPLIED AT THE RATE OF 2 TONS/ACRE OR AS DIRECTED BY THE RESIDENT ENGINEER.

TEMPORARY EROSION MATTING: TO BE PLACED ON EARTH SLOPES AS SHOWN ON THE PLANS, OR AS DIRECTED BY THE RESIDENT ENGINEER.

TOPSOIL: TO BE USED WITH SEED AS INDICATED ON THE PLANS OR AS DIRECTED BY THE RESIDENT ENGINEER.

PROJECT TYPICAL SECTIONS

PROJECT NAME: WALLINGFORD  
PROJECT NUMBER: STP ST WALK(I4)

FILE NAME: \$FILES\$  
PROJECT MANAGER: SUSAN SCRIBNER  
DESIGNED BY: L. HARDEN  
BRIDGE DESIGN SUPERVISOR: P. HALSTEAD

PLOT DATE: 1/9/2009  
DRAWN BY: W. WEATHERBY  
CHECKED BY: P. HALSTEAD  
SHEET 5 OF 26

