



**LATERAL BRACING PLAN**


SCALE 1/4" = 1'-0"  
0 2 4 6

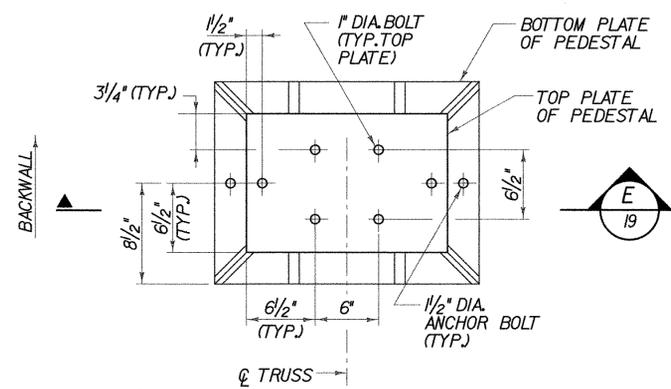


**PLAN - FIXED BEARING PEDESTAL (TOP)**  
T1 BEARING SHOWN, T2 BEARING SIMILAR (NOT TO SCALE)

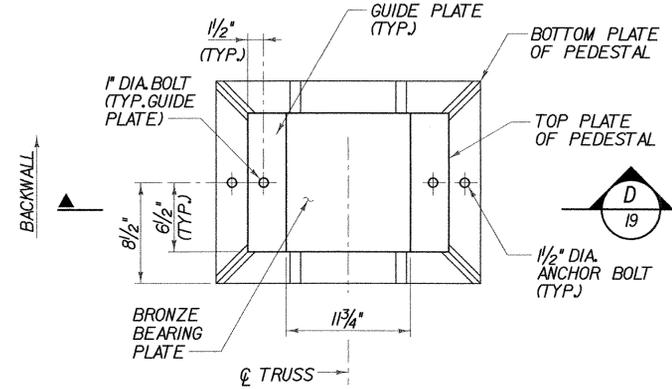


**PLAN - EXPANSION BEARING PEDESTAL (TOP)**  
T2 BEARING SHOWN, T1 BEARING SIMILAR (NOT TO SCALE)

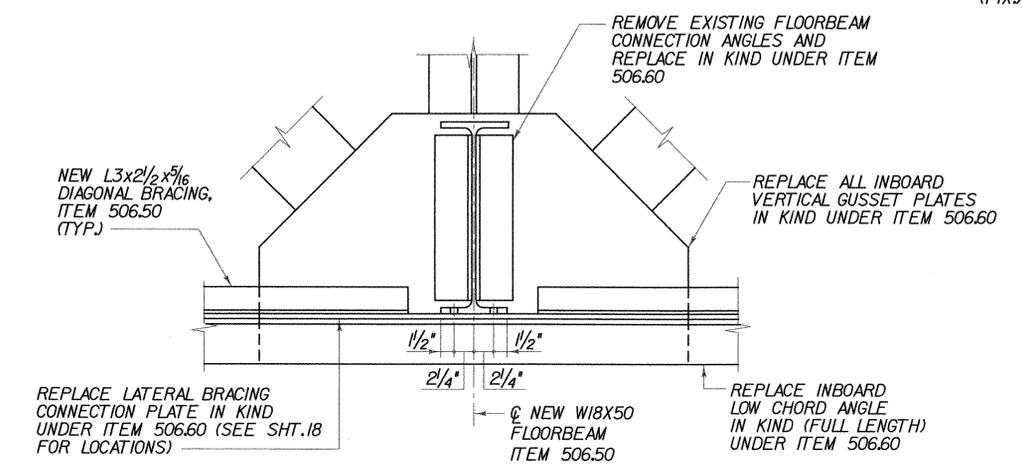


**A GUSSET TO FLOORBEAM CONNECTION**  
18 (CONNECTION AT L2, L4 & L6 SHOWN) (CONNECTION @ L0, L1, L3, L5, L7 & L8 SIMILAR) (NOT TO SCALE)

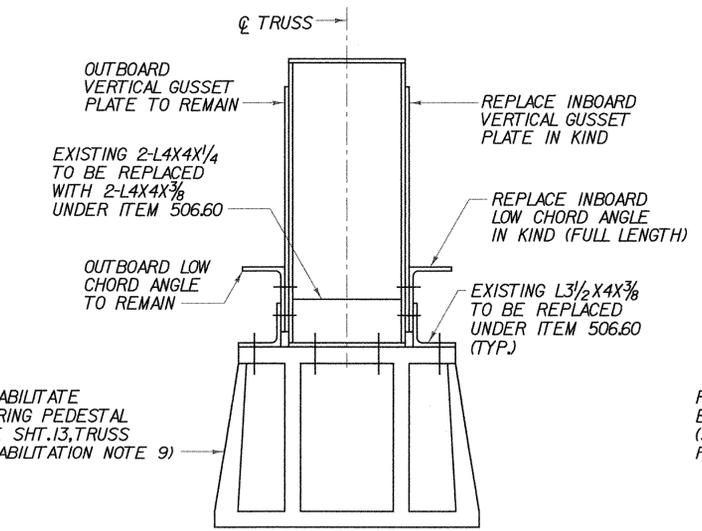

**E TYPICAL FIXED END**  
19 (NOT TO SCALE)

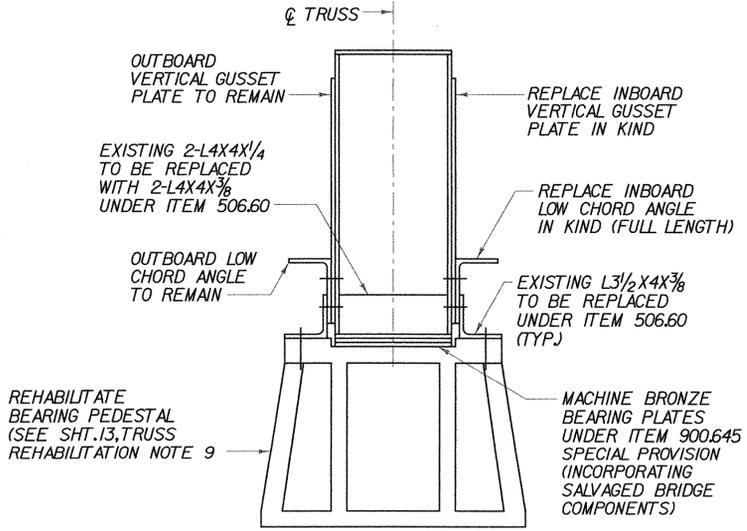

**D TYPICAL EXPANSION END**  
19 (NOT TO SCALE)

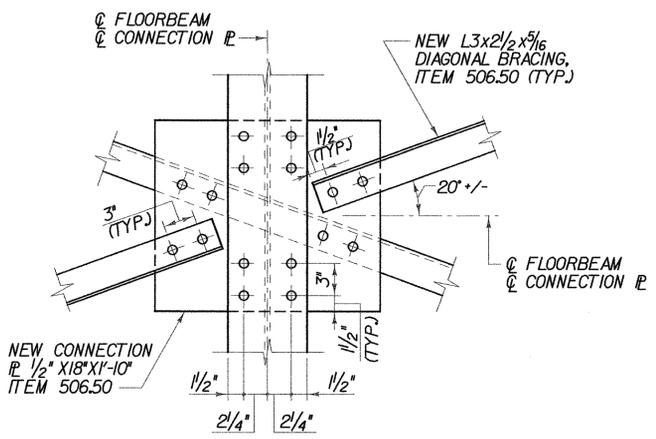

**B DIAGONAL BRACING CONNECTION AT MIDSPAN OF FLOORBEAM**  
19 (NOT TO SCALE)

- NOTES:**
- SEE SHT.13 FOR ADDITIONAL INFORMATION REGARDING PAYMENT AND REQUIRED SUBMITTALS.
  - WHERE NEW STRUCTURAL STEEL IS NOT FULLY DETAILED IN THE PLANS, THE CONTRACTOR SHALL DETAIL THE MEMBERS TO ACCOMMODATE FIELD FIT-UP AT COMPONENTS/MEMBERS TO BE REPLACED IN KIND.

**FRAMING PLAN AND DETAILS**

|                                 |                                       |                         |
|---------------------------------|---------------------------------------|-------------------------|
| PROJECT NAME: WALLINGFORD       | FILE NAME: \$FILES\$                  | PLOT DATE: 1/9/2009     |
| PROJECT NUMBER: STP ST WALK(14) | PROJECT MANAGER: SUSAN SCRIBNER       | DRAWN BY: W. WEATHERBY  |
|                                 | DESIGNED BY: L. HARDEN                | CHECKED BY: P. HALSTEAD |
|                                 | BRIDGE DESIGN SUPERVISOR: P. HALSTEAD | SHEET 19 OF 26          |



FILE NAME: \\A:\6659\ent\st\p\ref\incl.\submittal\2021136fmgsh.txdgn  
 DATE/TIME: 1/9/2009  
 USER: z2552