
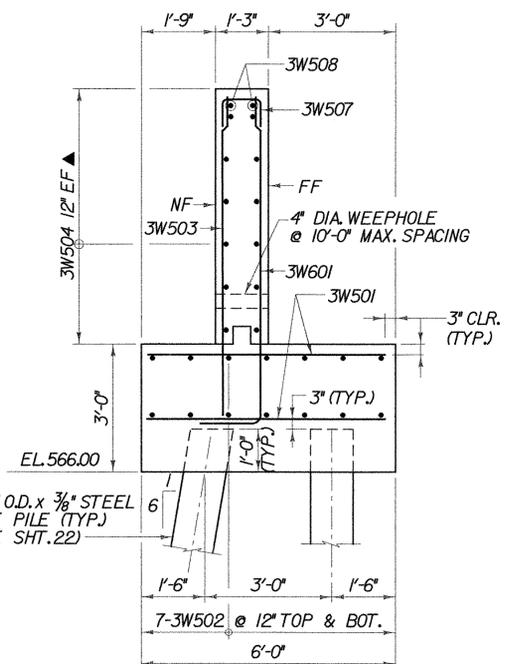




1/2" DIA. ANCHOR BOLTS
(DRILL AND GROUT WITH
15" EMBEDMENT IN CONCRETE)
ITEM 900.645 (TYP.)

EXISTING FIXED BEARING
PEDESTAL TO BE REINSTALLED
UNDER ITEM 900.645

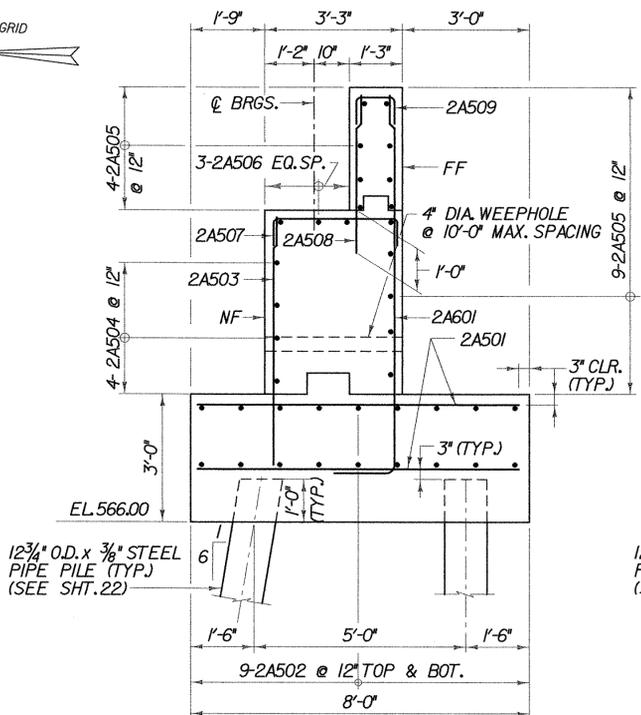

NOTES:

- THE 2A506 REINFORCEMENT BARS SHALL BE PLACED TO AVOID ANCHOR ROD PLACEMENT.

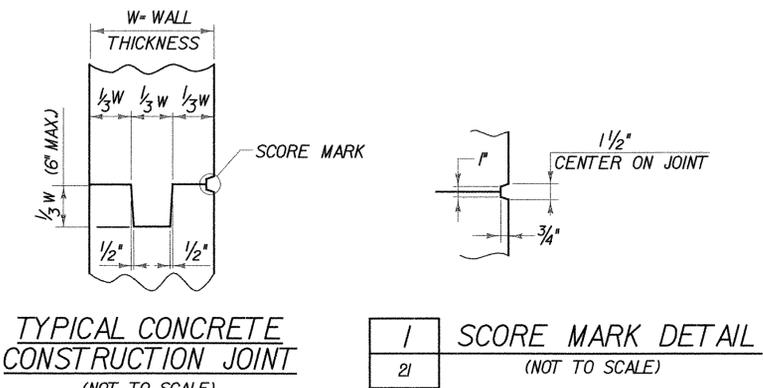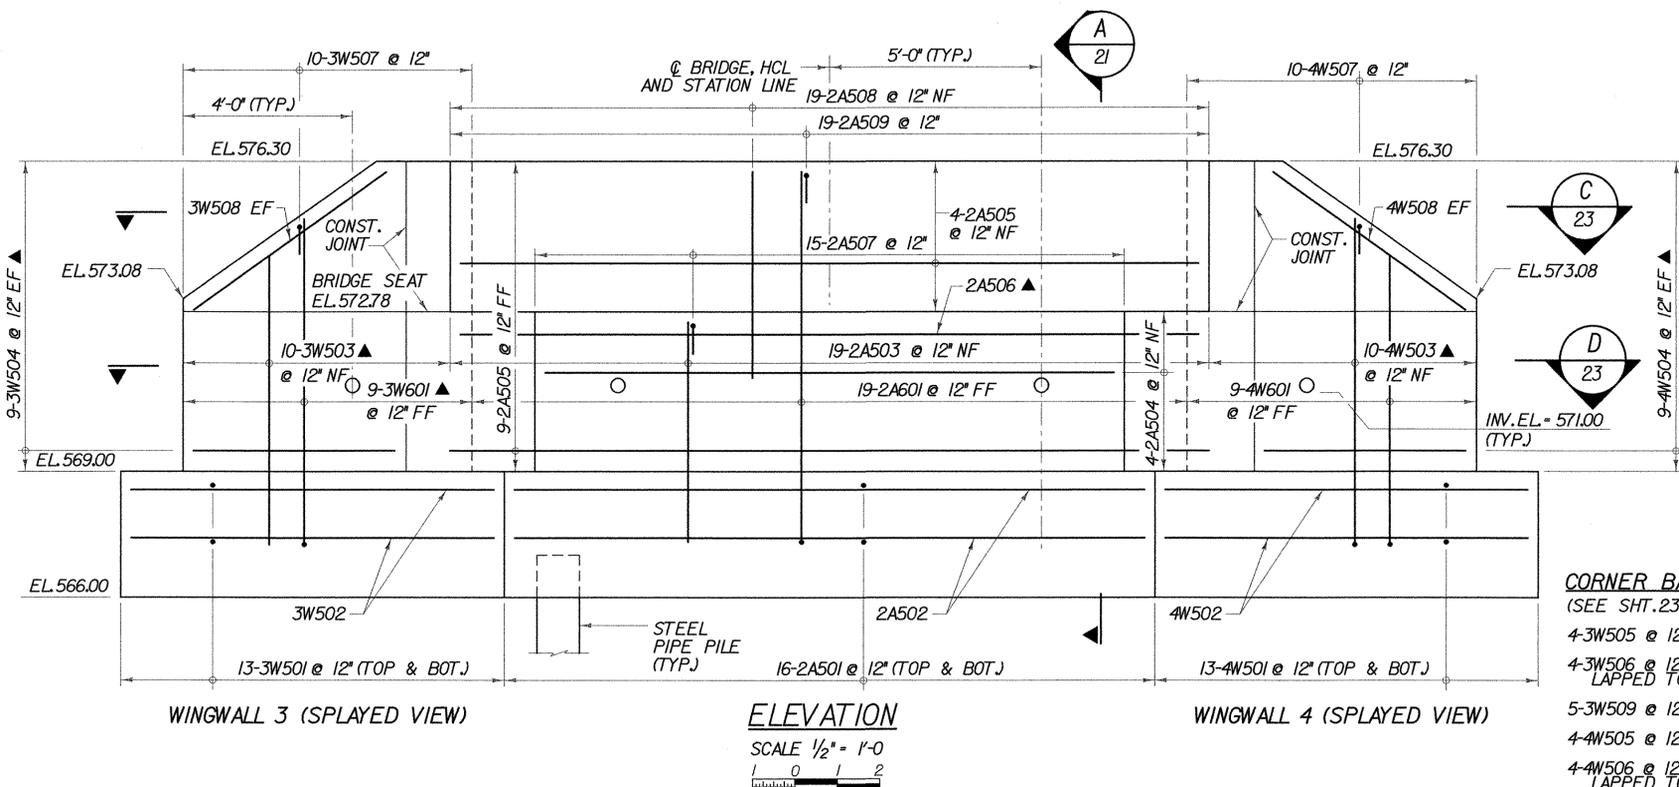

CORNER BARS NOT SHOWN FOR CLARITY:
(SEE SHT. 23 FOR DETAILS)

- 4-3W505 @ 12" LAPPED TO 2A504 & 3W504
- 4-3W506 @ 12" NF & 4-3W506 @ 12" FF LAPPED TO 2A505 & 3W504
- 5-3W509 @ 12" FF LAPPED TO 3W504
- 4-4W505 @ 12" LAPPED TO 2A504 & 4W504
- 4-4W506 @ 12" NF & 4-4W506 @ 12" FF LAPPED TO 2A505 & 4W504
- 5-4W509 @ 12" FF LAPPED TO 4W504

ABUTMENT 2 PLAN AND ELEVATION

PROJECT NAME:	WALLINGFORD	PLOT DATE:	1/9/2009
PROJECT NUMBER:	STP ST WALK(14)	DRAWN BY:	W. WEATHERBY
FILE NAME:	FILES#	DESIGNED BY:	L. HARDEN
PROJECT MANAGER:	SUSAN SCRIBNER	CHECKED BY:	P. HALSTEAD
BRIDGE DESIGN SUPERVISOR:	P. HALSTEAD	SHEET	21 OF 26



FILE NAME: s:\a\9669\meson\pr-ref.mel_submission\202136ac2\ht.dgn
DATE/TIME: 1/9/2009 11:20:01
USER: 22552