




RAIL LAYOUT PLAN
SCALE 1/4" = 1'-0"
1 0 2 4 6

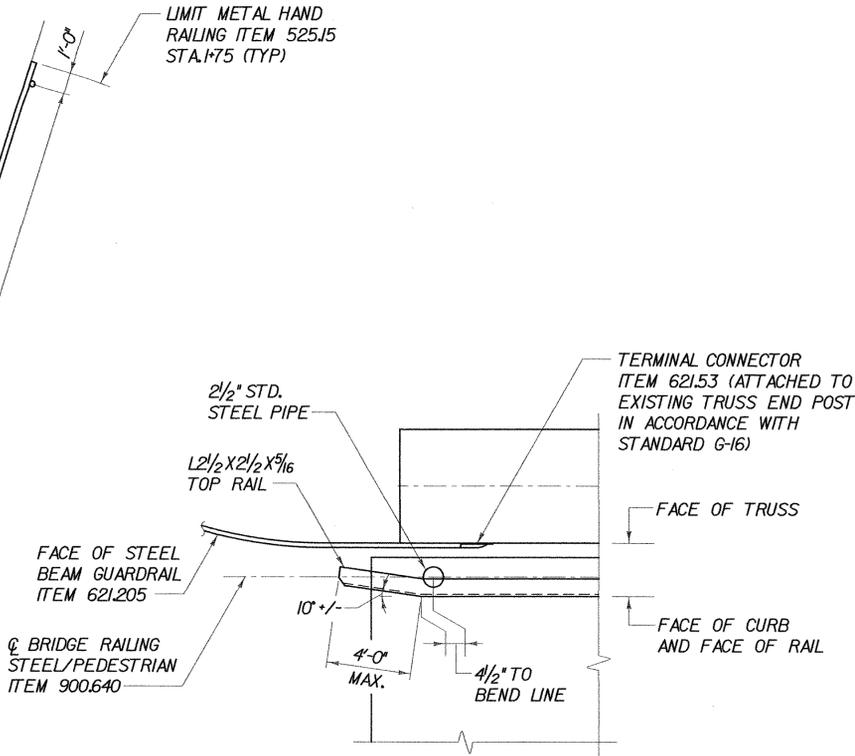

DETAIL 1
(NOT TO SCALE)

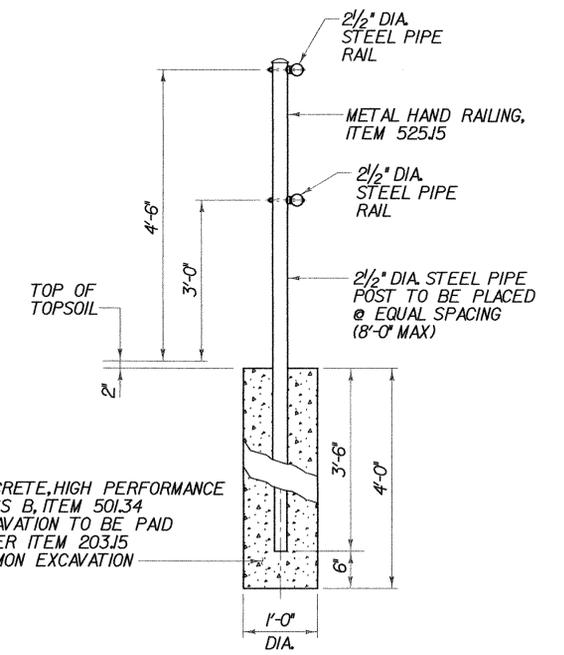

METAL HAND RAILING SECTION
(NOT TO SCALE)

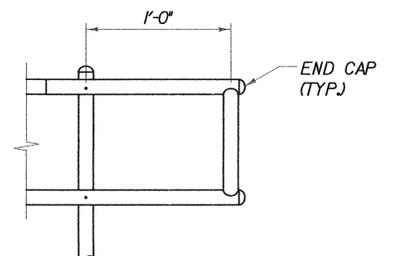

METAL HAND RAILING END ELEVATION
(NOT TO SCALE)

RAIL LAYOUT PLAN AND DETAILS

PROJECT NAME:	WALLINGFORD	PLOT DATE:	1/9/2009
PROJECT NUMBER:	STP ST WALK(14)	DRAWN BY:	W. WEATHERBY
FILE NAME:	FILES#	DESIGNED BY:	L. HARDEN
PROJECT MANAGER:	SUSAN SCRIBNER	BRIDGE DESIGN SUPERVISOR:	P. HALSTEAD
CHECKED BY:	P. HALSTEAD	SHEET	25 OF 26



FILE NAME: sub\86650\msh\proj\ref.msh\submission\2021136-ra1\shk\dgn
DATE/TIME: 1/9/2009 11:25:52
USER: 22652