


GENERAL NOTES:

- * ALL MEASUREMENTS TO BE VERIFIED BEFORE FABRICATION OF INDIVIDUAL MEMBERS BEGINS
- * ALL HOLES DRILLED IN NEW FABRICATED STEEL, TO MATCH EXISTING STEEL MEMBERS
- * ALL STRUCTURAL STEEL SHALL CONFORM TO AASHTO M-270 GRADE 50
- * UNLESS OTHERWISE NOTED, ALL HOLES SHALL BE DRILLED TO $1\frac{3}{8}$ " DIA
- * DIMENSIONS LESS THAN 25'-0" +/- $\frac{1}{8}$ "
- * DIMENSIONS GREATER THAN 25'-0" +/- $\frac{1}{8}$ "
- * SUPPORTING DOCUMENTATION TO DRAWINGS SEE BILL OF MATERIALS TRUSS TYPE 1 & 2
- * PAINT SYSTEM TO BE USED.
- * ALL PARTS TO BE PRIMED PRIOR TO INSTALLATION.


**NOTE: FOR FUTURE SUBMITTALS
PLEASE PROVIDE BILL OF
MATERIALS, INCLUDING
FASTENERS, ON THE SHEETS
WITH DETAILS.**

BEARING PEDESTAL:


**NOTE: HORIZONTAL LATERAL BRACING /
FLOOR BEAM CONNECTION
PLATES, SCHEDULED FOR
REPLACEMENT AT L0, L2, L4, L6 &
L8 ARE NOT INCLUDED IN THIS
SET.**

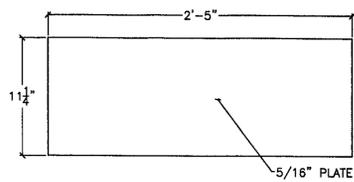


1BP01
3" = 1'-0"

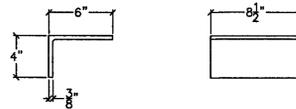

1BP03-ANGLE
3" = 1'-0"

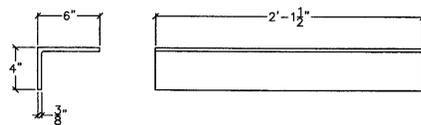

1BP02-ANGLE
3" = 1'-0"

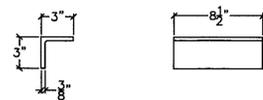

1BP04-ANGLE
3" = 1'-0"

RECEIVED
CK'D BY CHM OK'D BY _____
MAY 11 2009
APPROVED As Noted
BY WY DATE 5/28/09

Revised Blue Construction
Part (802) 257-7383

TITLE: Wallingford Bridge Rehab
LOCATION: Wallingford, VT
OWNER: Tru
DRAWING: Truss Type 1 General Notes & Drawings
DRAWN BY: JED JOB CONTACT: Erick Foster State of VT
CHECKED BY: JED/AD DATE: 4.30.09

DRAWING NO. T-1
SHEET NO. 1 of 17