



BEARING PEDESTAL:

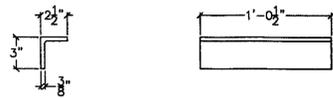


1BP05-ANGLE

3" = 1'-0"

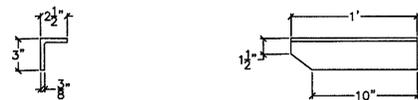

1BP06R-ANGLE

3" = 1'-0"

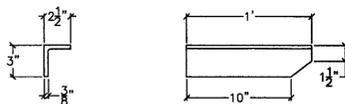

1BP06R-ANGLE

3" = 1'-0"

DIMENSIONS TBD

1BP07-PLATE

3" = 1'-0"

RECEIVED
 OK'D BY CHM OK'D BY _____
 MAY 1 1 2011
 R. U.S. APPROVED
 BY WJ DATE 5/1/11

Project: <u>Wallingford Bridge Rehab</u> Location: <u>Wallingford, VT</u> Drawing Title: <u>Drawings Truss Type 1 Drawings</u> Drawn By: <u>ED</u> Job Contact: <u>Erick Foster State of VT</u> Checked By: <u>ED/AD</u> Date: <u>4 30 09</u>	
Project No.: _____ Drawing No.: <u>T-1</u>	Project No.: _____ Drawing No.: _____
Sheet No.: <u>2 of 17</u>	

Project No.: _____
 Drawing No.: _____
 Project: Wallingford Bridge Rehab
 Location: Wallingford, VT
 Drawing Title: Drawings Truss Type 1 Drawings
 Drawn By: ED Job Contact: Erick Foster State of VT
 Checked By: ED/AD Date: 4 30 09