



BEARING PEDESTAL:

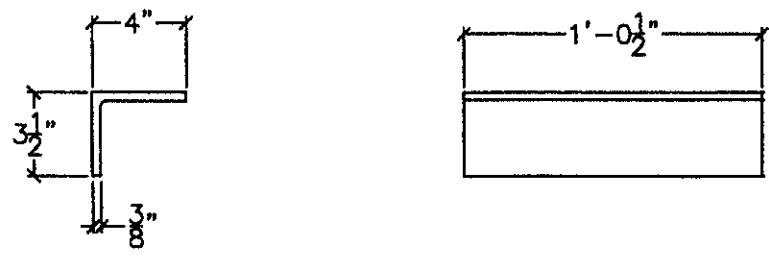

1BA01-ANGLE  
3" = 1'-0"

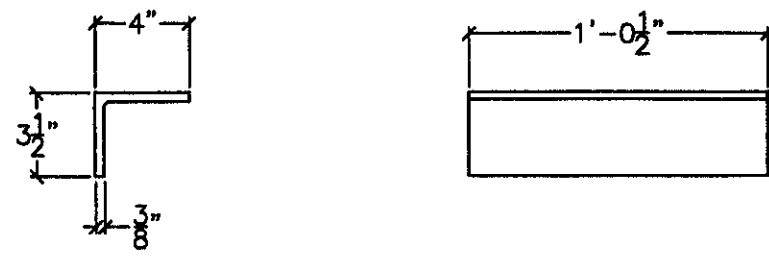

1BA02-ANGLE  
3" = 1'-0"

RECEIVED  
CK'D BY CWA OK'D BY \_\_\_\_\_  
MAY 11 2011  
APPROVED /  
BY WJ DATE 5/11/11

|                                                                     |                                 |
|---------------------------------------------------------------------|---------------------------------|
| Renard Bros Construction<br>Professional Engineer<br>(802) 257-7383 |                                 |
|                                                                     |                                 |
| TITLE                                                               | Wallingford Bridge Rehab        |
| LOCATION                                                            | Wallingford, VT                 |
| DRAWING TITLE                                                       | Drawings Truss Type 1: Drawings |
| DRAWN BY                                                            | JED                             |
| CHECKED BY                                                          | JED/AD                          |
| DATE                                                                | 4 30 09                         |
| PROJECT NO.                                                         | T-1                             |
| SHEET NO.                                                           | 3 OF 17                         |