



LATTICE:

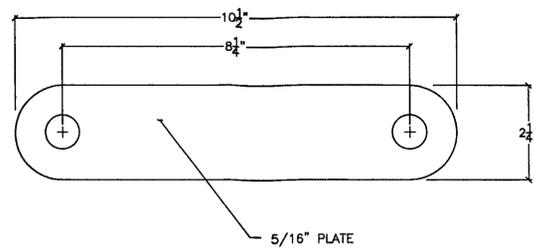

1LP01-PLATE

1'-0" = 1'-0"

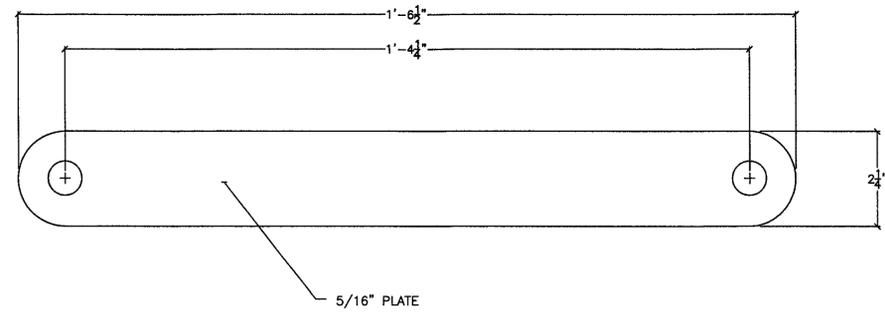

1LP02-PLATE

1'-0" = 1'-0"

RECEIVED
OK'D BY CWA OK'D BY _____
MAY 11 2009
BY WJ / SJS APPROVED
DATE 5/11/09

Renard Bros. Construction Reno, VT (802) 257-7383	
TITLE: Wallingford Bridge Rehab LOCATION: Wallingford, VT	
DRAWING TITLE: Drawings Truss Type 1 Drawings	DATE: 4 30 09
DRAWN BY: JED	JOB CONTACT: Erick Foster State of VT
CHECKED BY: ED/AD	
DRAWING NO.:	T-1
SHEET NO.:	4 OF 17