




UPPER CHORD:

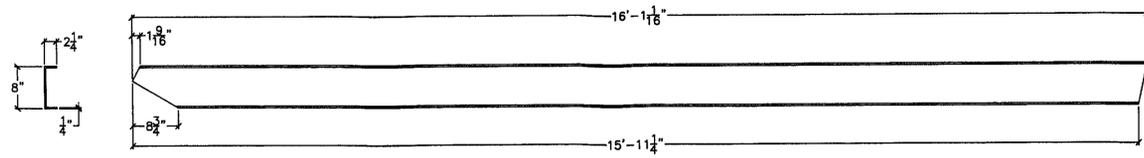

1LOU1-CHANNEL
1-1/2" = 1'-0"

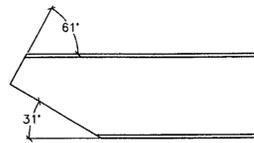

1LOU1-END DETAIL
3" = 1'-0"

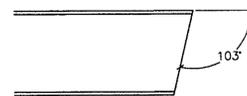

1LOU1-END DETAIL
3" = 1'-0"

RECEIVED
MAY 11 2009
BY *WJ* DATE *5/11/09*

Pennud Inc. Construction 1000 W. Main St. (802) 257-7283	
FILE: Wallingford Bridge Rehab LOCATION: Wallingford, VT DRAWING TITLE: Drawings Truss Type 1. Drawings DRAWN BY: JED JOB CONTACT: Eric Foster State of VT CHECKED BY: JED/AD DATE: 4.30.09	SHEET NO. T-1 5 OF 17