




UPPER CHORD:

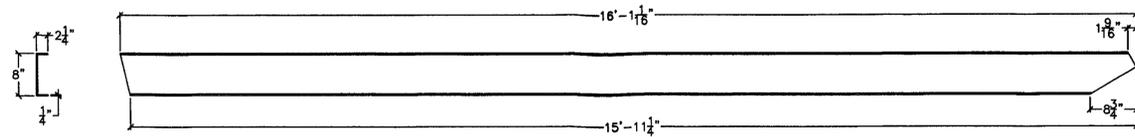

1L8U7-CHANNEL
1-1/2" = 1'-0"

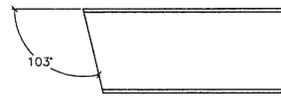

1L8U7-END DETAIL
3" = 1'-0"

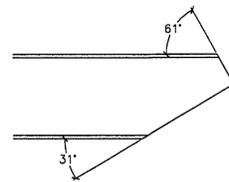

1L8U7-END DETAIL
3" = 1'-0"

RECEIVED
 OK'D BY: CLM OK'D BY: _____
 MAY 11 2009
 R. S. ... APPROVED ✓
 BY: WJ DATE: 5/12/09

Project: <u>Wallingford Bridge Rehab</u> Location: <u>Wallingford, VT</u> Drawing Title: <u>Drawings Truss Type 1</u> Drawn By: <u>JED</u> Checked By: <u>ED/AD</u>	
Job Contract: <u>Enck Foster State of VT</u> Date: <u>4 30 09</u>	Sheet No.: <u>T-1</u> 6 of 17

Enck Foster Construction
 1000 Main Street
 Wallingford, VT 05488
 (802) 257-7383