




UPRIGHT MEMBERS:

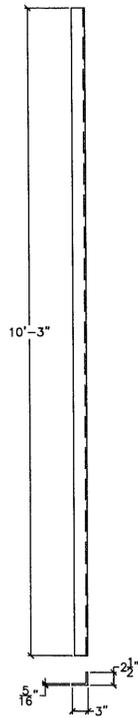

1U2L2L-ANGLE
1-1/2" = 1'-0"

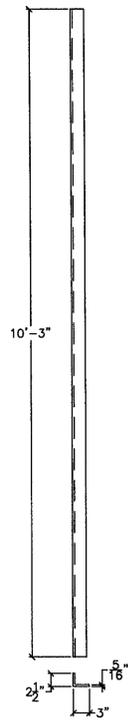

1U2L2R-ANGLE
1-1/2" = 1'-0"

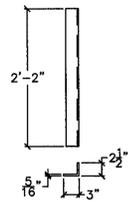

1U3L3L-ANGLE
1-1/2" = 1'-0"

RECEIVED
 OK'D BY CWA OK'D BY _____
 MAY 1 1 2009
 BY WY SJ DATE 5/1/09

RENAUD BROS. CONSTRUCTION 1000 W. MAIN ST. WASHINGTON, VT 05677-2885 (802) 257-7385
WALLINGFORD BRIDGE REHAB WALLINGFORD, VT
DRAWING TITLE: Drawings Truss Type 1 Drawings DRAWN BY: JED JOB CONTACT: Erick Foster State of VT CHECKED BY: JED/AD DATE: 4 30 09
DRAWING NO.: T-1
SHEET NO.: 7 OF 17