




UPRIGHT MEMBERS:

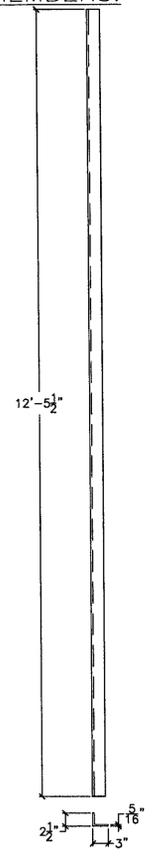

1U3L3R-ANGLE
1-1/2" = 1'-0"

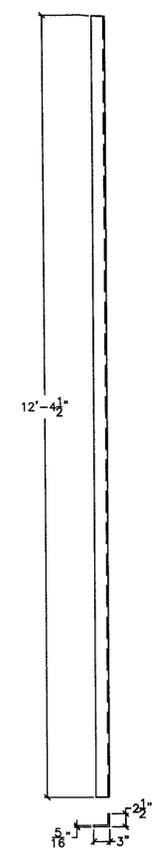

1U4L4L-ANGLE
1-1/2" = 1'-0"

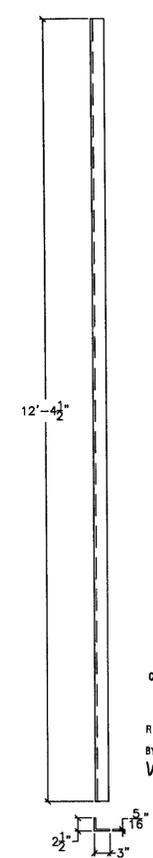

1U4L4R-ANGLE
1-1/2" = 1'-0"

RECEIVED
 CK'D BY: CHA OK'D BY: _____
 MAY 1 12:01
 BY: WJ DATE: 5/1/09

Rinaldi Bros. Construction 1000 W. Main St. (802) 257-7383	
FILE LOCATION DRAWING TITLE DRAWN BY: <u>LED</u> CHECKED BY: <u>ED/AD</u>	Wallingford Bridge Rehab Wallingford, VT Drawings Truss Type 1 Drawings JOB CONTACT: <u>Erick Foster State of VT</u> DATE: <u>4 30 09</u>
DRAWING NO. T-1	SHEET NO. 8 of 17