



UPRIGHT MEMBERS:

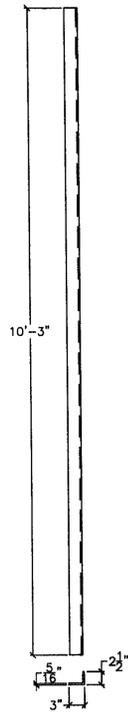

1U6L6L-ANGLE
1-1/2" = 1'-0"

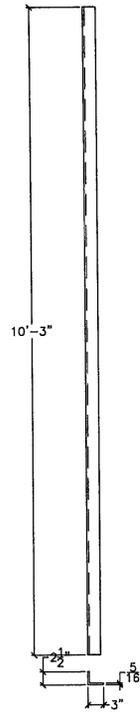

1U6L6R-ANGLE
1-1/2" = 1'-0"

RECEIVED
 CK'D BY CHB OK'D BY _____
 MAY 11 2009
 BY WJY DATE 5/19/09

TITLE: Wallingford Bridge Rehab LOCATION: Wallingford, VT DRAWING TITLE: Drawings Truss Type 1 Drawings DRAWN BY: JED CHECKED BY: JED/AD DATE: 4 30 09		Renewal Bros. Construction 1000 State Street (802) 257-7383
DRAWING NO.: T-1		
SHEET NO.: 9 of 17		