

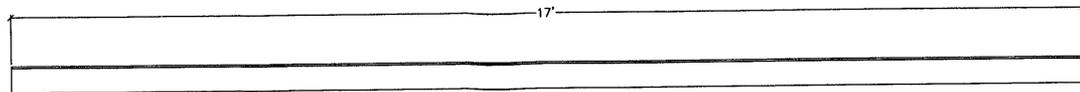
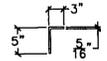




UPRIGHT MEMBERS:

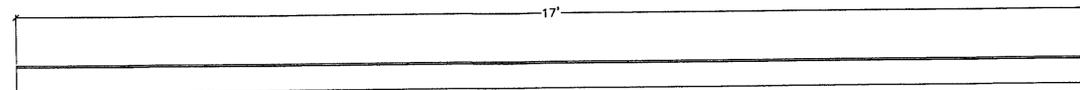

1DM01-ANGLE  
1-1/2" = 1'-0"

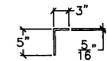

1DM02-ANGLE  
1-1/2" = 1'-0"

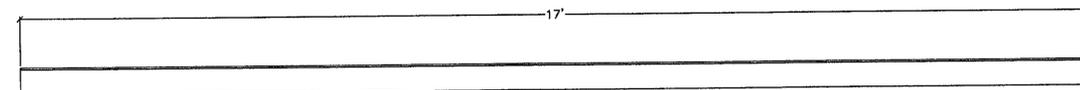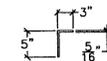

1DM03-ANGLE  
1-1/2" = 1'-0"

RECEIVED  
 CK'D BY: CHA OK'D BY: \_\_\_\_\_  
 MAY 11 2009  
 BY: WY Sp APPROVED: \_\_\_\_\_  
 DATE: 5/11/09

Revised Plus Construction For Bridge and Heavy VT 0534 (802) 257-7563	
TITLE: Wallingford Bridge Rehab LOCATION: Wallingford, VT	DRAWING NO. T-1
DRAWING TITLE: Drawings Truss Type 1 Drawings DRAWN BY: JED CHECKED BY: SED/AD	JOB CONTRACT: Enck Foster State of VT DATE: 4 30 09
11 of 17	