



BOTTOM CHORD:

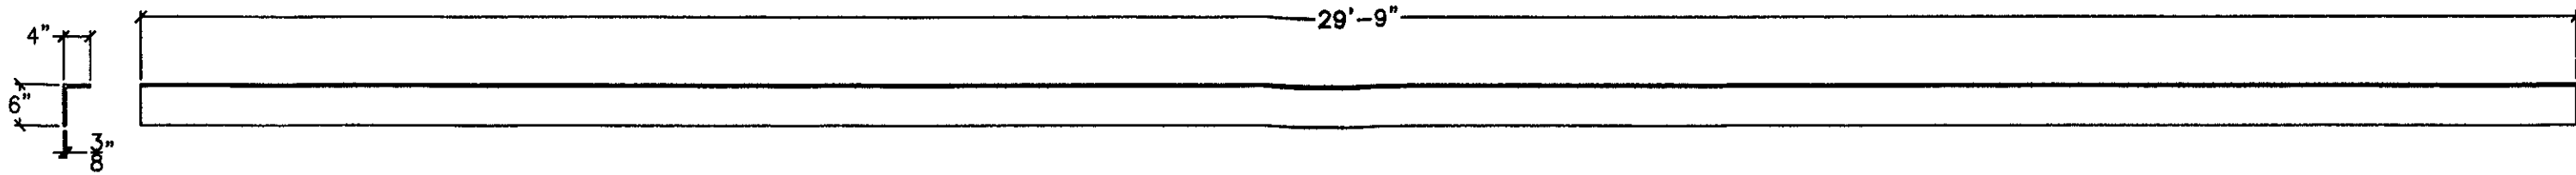


1L2L4A-ANGLE

1" = 1'-0"

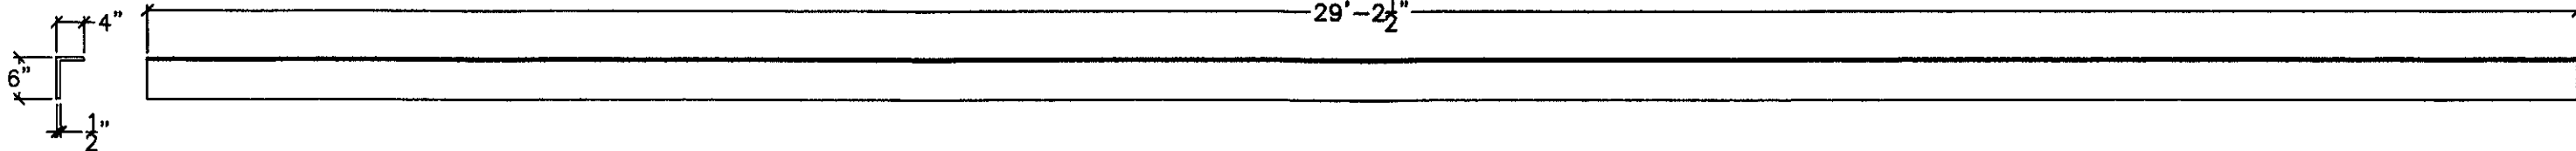

1L2L4A-ANGLE

1" = 1'-0"

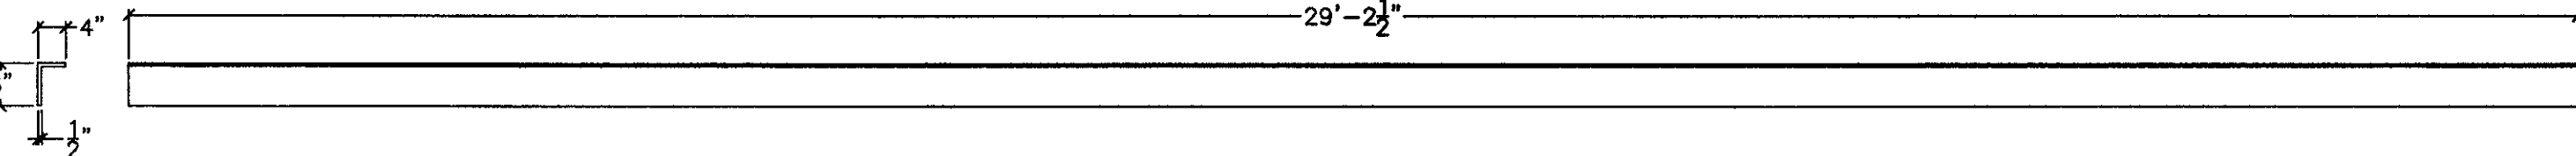

1L2L4B-ANGLE

1" = 1'-0"

RECEIVED  
CHK'D BY CWA OK'D BY \_\_\_\_\_

MAY 11 2009

BY WJ DATE 5/29/09

|                                                                          |               |
|--------------------------------------------------------------------------|---------------|
| Renaud Bros. Construction<br>Renaud Bros. Construction<br>(802) 257-7353 |               |
| TITLE: Wallingford Bridge Rehab<br>LOCATION: Wallingford, VT             |               |
| DRAWING TITLE: Drawings Truss Type 1 Drawings                            | DRAWN BY: JED |
| CHECKED BY: JED/AD                                                       | DATE: 4/30/09 |
| JOB CONTACT: Erick Foster State of VT                                    |               |
| DRAWING NO.: T-1                                                         |               |
| SHEET NO.: 13 OF 17                                                      |               |