



BOTTOM CHORD:

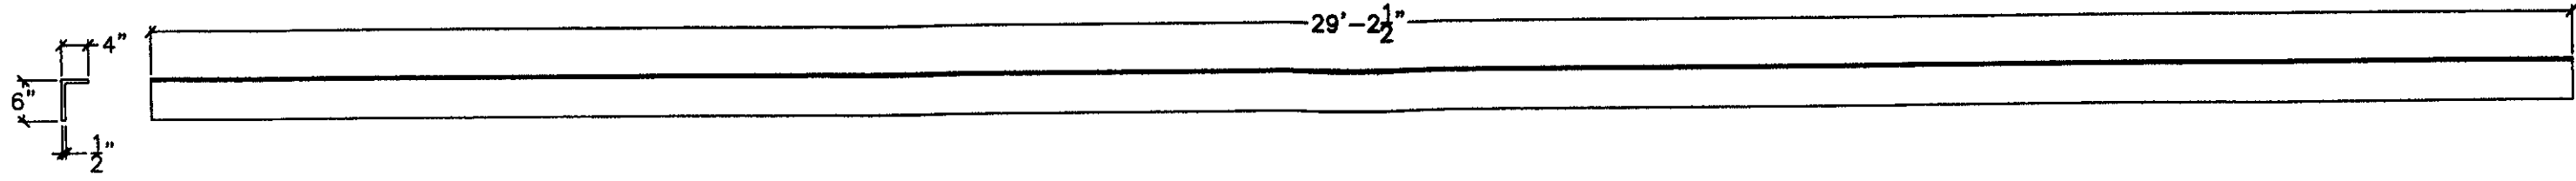


1L4L6A-ANGLE

1" = 1'-0"

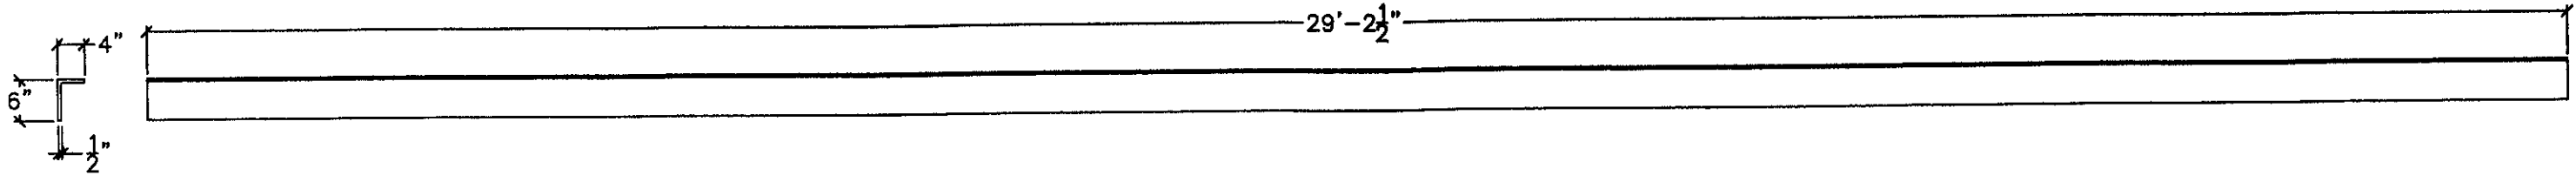

1L4L6B-ANGLE

1" = 1'-0"

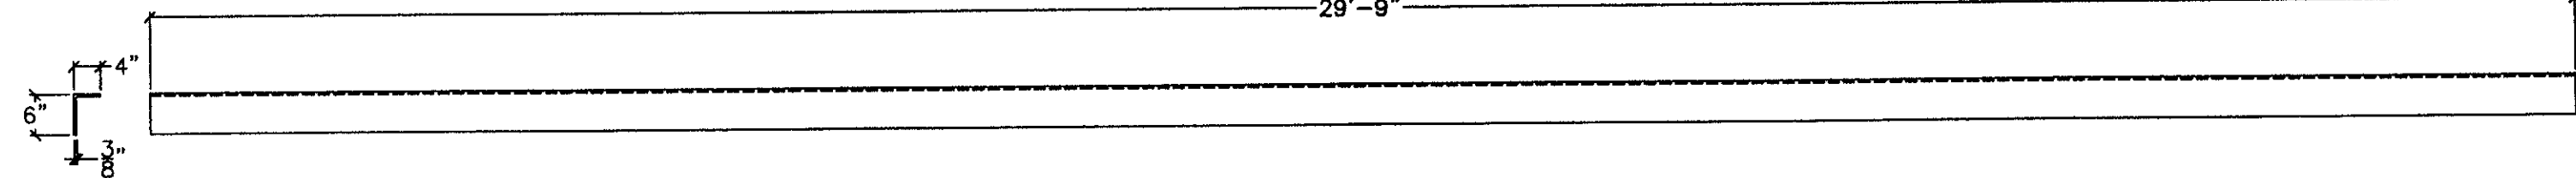

1L6L8A-ANGLE

1" = 1'-0"

RECEIVED
 MAY 11 2009
 BY *WJ* DATE *5/11/09*

Project: Wallingford Bridge Rehab Location: Wallingford, VT Drawing Title: Drawings Truss Type 1- Drawings Drawn By: JED Checked By: JED/AD		Revised Eng. Construction For Bridge Rep. Mem. VT 0304 (802) 257-7383
Drawing No.: T-1 Sheet No.: 14 of 17	Job Contact: Erik Foster State of VT Date: 4/30/09	