



BOTTOM CHORD:

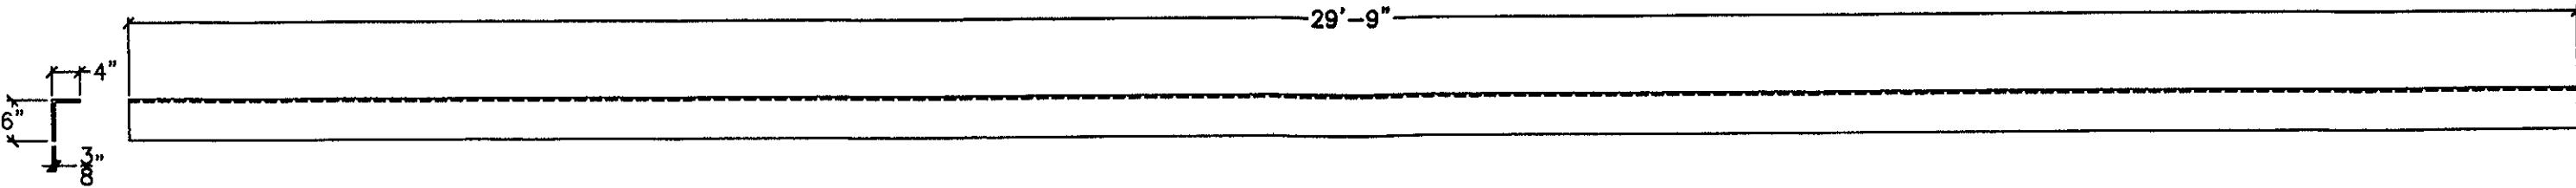

1L6L8B-ANGLE

1" = 1'-0"

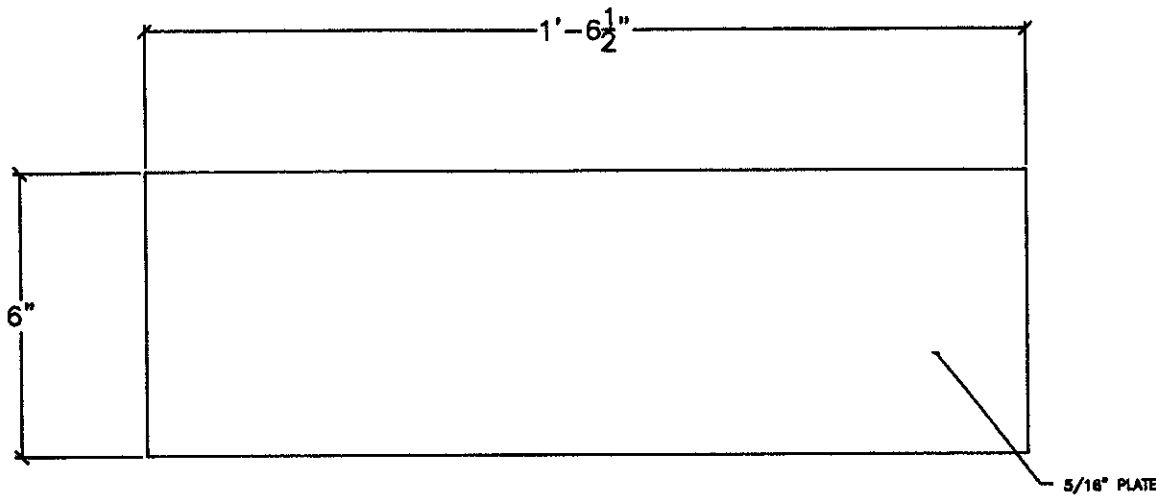

1BC01-PLATE

3" = 1'-0"

RECEIVED
OK'D BY CWA OK'D BY _____
MAY 11 2009
BY WY g DATE 5/11/09

Renold Bros. Construction For Bridge and Heavy VT 0554 (802) 257-7383	
TITLE: Wallingford Bridge Rehab LOCATION: Wallingford, VT	
DRAWING TITLE: Drawings Truss Type 1 Drawings	DRAWN BY: JED JOB CONTACT: Erick Foster State of VT
CHECKED BY: JED/AD	DATE: 4 30 09
DRAWING NO.:	T-1
SHEET NO. 15 OF 17	