




GUSSET PLATES:

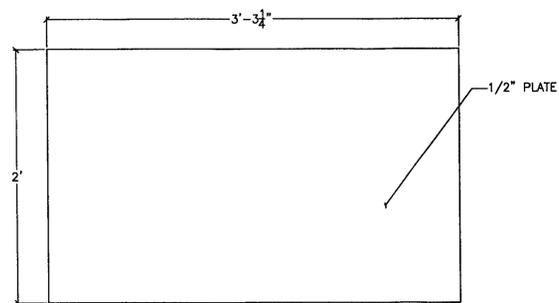

1GP01
3" = 1'-0"

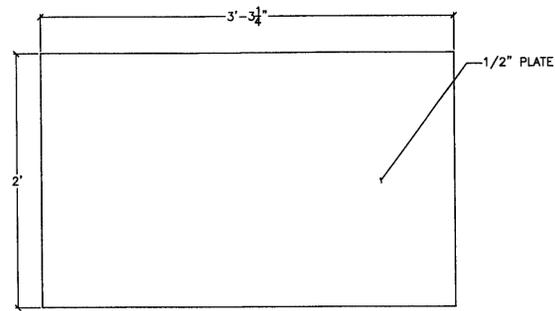

1GP02
3" = 1'-0"

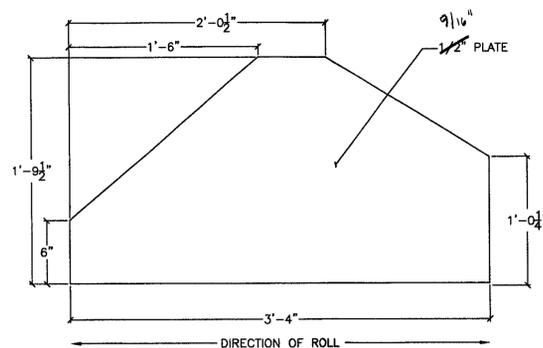

1GP03
3" = 1'-0"

RECEIVED
CHK'D BY CMA OK'D BY _____

MAY 11 2009
BY WY DATE 5/11/09

Project: Wallingford Bridge Rehab Location: Wallingford, VT	
DRAWING TITLE: Drawings Truss Type 1 Drawings DRAWN BY: JED CHECKED BY: ED/AD	JOB CONTACT: Erick Foster State of VT DATE: 4 30 09
DRAWING NO.: T-1	SHEET NO.: 16 OF 17

Project: **Wallingford Bridge Rehab**
 Location: **Wallingford, VT**
 (802) 257-7383