



GUSSET PLATES:

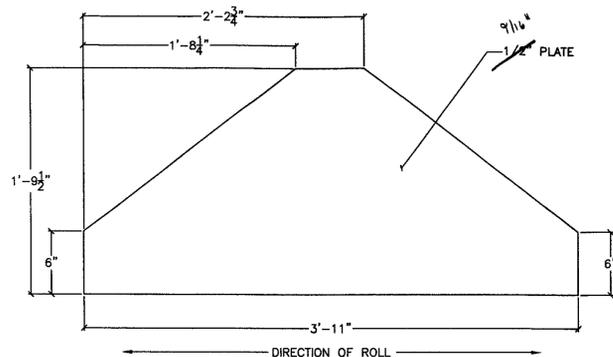

1GP04

3" = 1'-0"

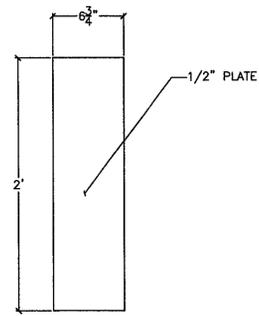

1GP05

3" = 1'-0"

RECEIVED
 OK'D BY: CHA OK'D BY: _____
 MAY 11 2009
 BY: WJ DATE: 5/11/09

Revised Plus Construction Fort Belknap Road, Helena, MT 59604 (406) 257-7363
TITLE: <u>Wallingford Bridge Rehab</u> LOCATION: <u>Wallingford, VT</u> DRAWING NO.: <u>T-1</u> SHEET NO.: <u>17 OF 17</u>
DRAWING TYPE: <u>Drawings</u> DRAWN BY: <u>JED</u> JOB CONTACT: <u>Erick Foster</u> STATE OF: <u>VT</u> CHECKED BY: <u>JED/AD</u> DATE: <u>4 30 09</u>