


GENERAL NOTES:


- * ALL MEASUREMENTS TO BE VERIFIED BEFORE FABRICATION OF INDIVIDUAL MEMBERS BEGINS
- * ALL HOLES DRILLED IN NEW FABRICATED STEEL, TO MATCH EXISTING STEEL MEMBERS
- * ALL STRUCTURAL STEEL SHALL CONFORM TO AASHTO M-270 GRADE 50
- * UNLESS OTHERWISE NOTED, ALL HOLES SHALL BE DRILLED TO $\frac{1}{8}$ " DIA
- * DIMENSIONS LESS THAN 25'-0" +/- $\frac{1}{16}$ "
- * DIMENSIONS GREATER THAN 25'-0" +/- $\frac{1}{8}$ "
- * SUPPORTING DOCUMENTATION TO DRAWINGS SEE BILL OF MATERIALS TRUSS TYPE 1 & 2.
- * PAINT SYSTEM TO BE USED.

BEARING PEDESTAL:

NOTE: HORIZONTAL LATERAL BRACING / FLOOR BEAM CONNECTION PLATES, SCHEDULED FOR REPLACEMENT AT L0, L2, L4, L6 & L8 ARE NOT INCLUDED IN THIS SET.

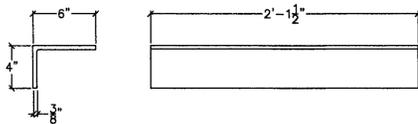

2BP01-ANGLE
3" = 1'-0"

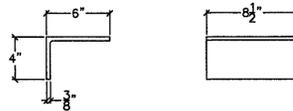

2BP03-ANGLE
3" = 1'-0"

NOTE: FOR FUTURE SUBMITTALS PLEASE PROVIDE BILL OF MATERIALS, INCLUDING FASTENERS, ON THE SHEETS WITH DETAILS.

RECEIVED
 OK'D BY CWA OK'D BY _____
 MAY 11 2009
 RE-SUBMIT _____ APPROVED A. N. W.
 BY WY DATE 5/14/09

TITLE: Wallingford Bridge Rehab LOCATION: Wallingford, VT DRAWING TITLE: Drawings Truss Type 2: General Notes & Drawings DRAWN BY: JED CHECKED BY: JED/JAB JOB CONTACT: Erick Foster State of VT DATE: 4 30 09		Renaud Bros Construction Performance Systems, VT 05504 (802) 251-7300
SHEET NO. T-2	SHEET NO. 1 of 18	