



BEARING PEDESTAL CONT.:

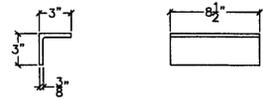


2BP04-ANGLE

3" = 1'-0"

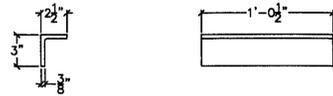


2BP05-ANGLE

3" = 1'-0"

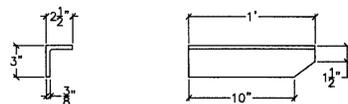

2BP06R-ANGLE

3" = 1'-0"

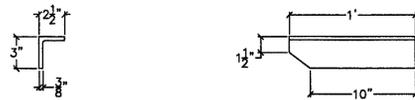

2BP06L-ANGLE

3" = 1'-0"

RECEIVED

OK'D BY C.H.A. OK'D BY _____

MAY 11 2009

R. SUEWIT APPROVED As Noted

BY WJ DATE 5/11/09

PERMANENT BRIDGE CONSTRUCTION (802) 257-7353	
TITLE: Wallingford Bridge Rehab LOCATION: Wallingford, VT DRAWING TITLE: Drawings Truss Type 2: Drawings DRAWN BY: JED JOB CONTACT: Erik Foster State of VT CHECKED BY: JED/AD DATE: 4.30.09	
DRAWING NO.: SHEET NO.: T-2	
	2 OF 18