
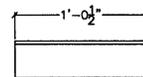


BEARING PEDESTAL CONT.:

TBD WHEN REMOVED
DWG. SUBMITTED FOR
APPROVAL



2BP07-PLATE

3" = 1'-0"

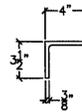

2BA01-ANGLE

3" = 1'-0"

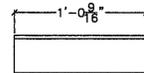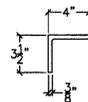

2BA02-ANGLE

3" = 1'-0"

RECEIVED
 CK'D BY CHS OK'D BY _____
 MAY 11 2009
 R-SUE:WIT APPROVED As Mth
 BY SY DATE 5/11/09
WY

Renewal Bros. Construction 1000 W. Main Street (802) 257-1282	
TITLE: Wallingford Bridge Rehab LOCATION: Wallingford, VT	DRAWING TITLE: Drawings Truss Type 2: Drawings DRAWN BY: LED JOB CONTACT: Erick Foster State of VT CHECKED BY: ED/AD DATE: 4-30-09
DRAWING NO.	T-2
SHEET NO.	3 of 18