



LATTICE:

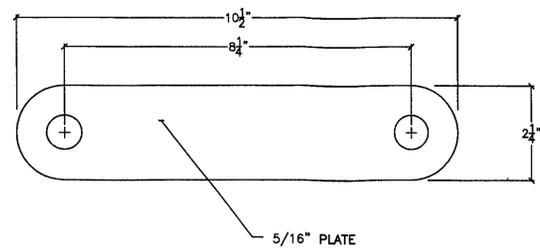

2LP01-PLATE

3" = 1'-0"

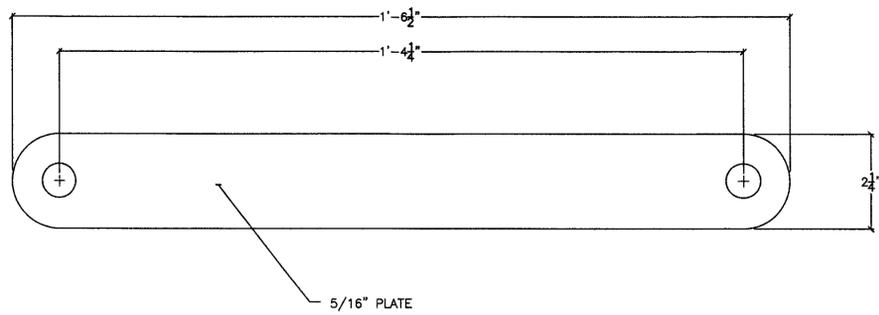

2LP02-ANGLE

3" = 1'-0"

RECEIVED
CKD BY CH OKD BY _____
MAY 11 2009
R SUBMITTED BY WY APPROVED As Noted
DATE 5/11/09

PROJECT	Wallingford Bridge Rehab
LOCATION	Wallingford, VT
DRAWING TITLE	Drawings Truss Type 2: Drawings
DRAWN BY	JED
CHECKED BY	ED/AD
DATE	4 30 09
JOB CONTACT	Erick Foster State of VT
PROJECT NO.	
DRAWING NO.	T-2
SHEET NO.	4 OF 18