




UPPER CHORD:

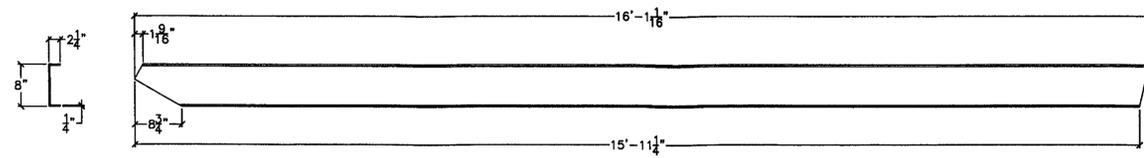

2L8U7-CHANNEL
1-1/2" = 1'-0"

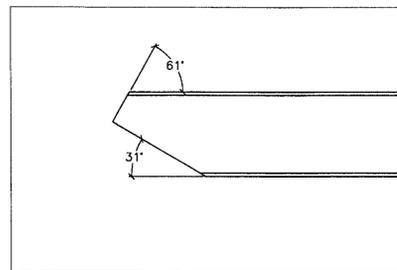

2L8U7-END DETAIL
3" = 1'-0"

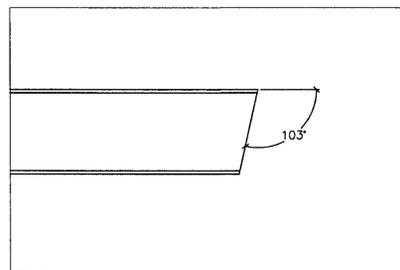

2L8U7-END DETAIL
3" = 1'-0"

RECEIVED
MAY 11 2009
APPROVED BY *[Signature]*
DATE *5/11/09*

REVAUD BROS. CONSTRUCTION 100 W. MAIN ST. #201 WASHINGTON, VT 05677-2385 (802) 257-7385
WALLINGFORD BRIDGE REHAB WALLINGFORD, VT
DRAWING TITLE Drawings Truss Type 2 Drawings
DRAWN BY: JED JOB CONTACT: Erick Foster, State of VT
CHECKED BY: ED/AD DATE: 4.30.09
DRAWING NO.: T-2
SHEET NO.: 5 OF 18