

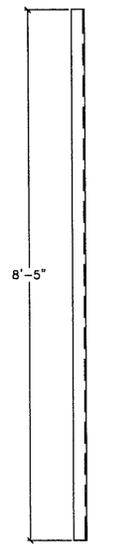



UPRIGHT MEMBERS:

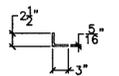

2U1L1L-ANGLE
1-1/2" = 1'-0"

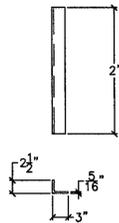

2U1L1R-ANGLE
1-1/2" = 1'-0"

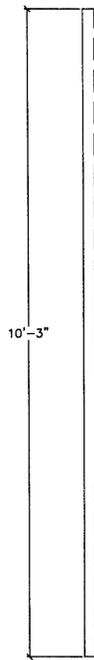

RECEIVED
 CK'D BY CHB OK'D BY _____
 MAY 11 2009
 R. U. G. MIT APPROVED As Noted
 BY WJ DATE 5/11/09

2U2L2L-ANGLE
1-1/2" = 1'-0"

FILE: Wallingford Bridge Rehab LOCATION: Wallingford, VT DRAWING TITLE: Drawings Truss Type 2 Drawings DRAWN BY: JED JOB CONTRACT: Erick Foster State of VT CHECKED BY: ED/AD DATE: 4.30.09		Renaud Bros. Construction 1000 Main Street (802) 257-1285
DRAWING NO. T-2		
SHEET NO. 6 of 18		