

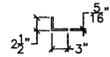
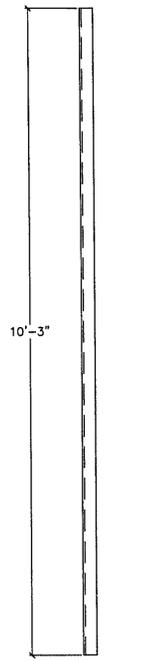




UPRIGHT MEMBERS:

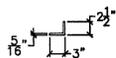

2U2L2R-ANGLE
1-1/2" = 1'-0"

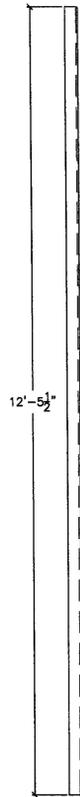

2U3L3L-ANGLE
1-1/2" = 1'-0"

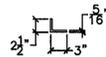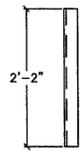

2U3L3R-ANGLE
1-1/2" = 1'-0"

RECEIVED
 CK'D BY CMB OK'D BY _____
 MAY 11 2009
 R. J. GILIT APPROVED As Noted
 BY gq DATE 5/11/09
WJ

TITLE: Wallingford Bridge Rehab LOCATION: Wallingford, VT DRAWING TITLE: Drawings Truss Type 2- Drawings DRAWN BY: JSD JOB CONTACT: Erick Foster State of VT CHECKED BY: ED/AD DATE: 4-30-09		Prepared By: Construction Revised: 1/27/09 (802) 257-7253
DRAWING NO.	T-2	
SHEET NO.	7 of 18	