

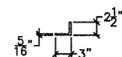
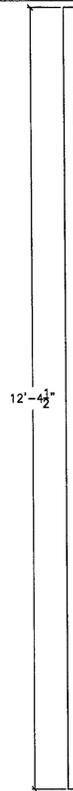



UPRIGHT MEMBERS:

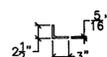

**2U4L4L-ANGLE**  
1-1/2" = 1'-0"

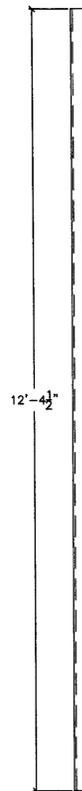

**2U4L4R-ANGLE**  
1-1/2" = 1'-0"

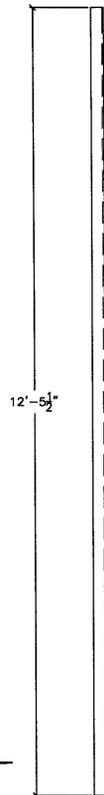

**2U5L5L-ANGLE**  
1-1/2" = 1'-0"

RECEIVED  
 OK'D BY CHA OK'D BY \_\_\_\_\_  
 MAY 11 2009  
 R. J. G. H. T. APPROVED AS  
 BY SA DATE 5/11/09

RENOUD BROS. CONSTRUCTION 1000 W. MAIN ST. FERRIS, VT 05747 (802) 257-7385	
TITLE: Wallingford Bridge Rehab LOCATION: Wallingford, VT	DRAWING TITLE: Drawings Truss Type 2: Drawings DRAWN BY: LED CHECKED BY: ED/AD
JOB CONTACT: Erick Foster State of VT DATE: 4.30.09	SHEET NO.: T-2 8 of 18