



UPRIGHT MEMBERS:

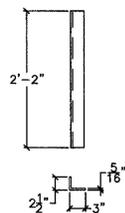


2U5L5R-ANGLE
1-1/2" = 1'-0"

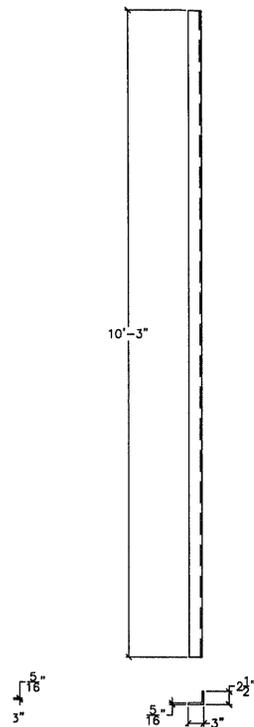

2U6L6L-ANGLE
1-1/2" = 1'-0"

RECEIVED
 OK'D BY CHA OK'D BY _____
 MAY 11 2009
 R. ... APPROVED A. M. H.
 BY WY DATE 5/11/09

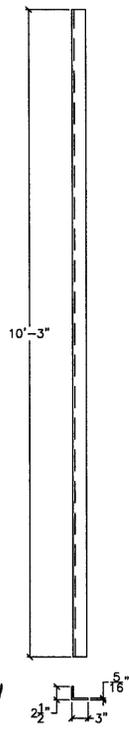

2U6L6R-ANGLE
1-1/2" = 1'-0"

| | |
|--|--|
| TITLE: Wallingford Bridge Rehab LOCATION: Wallingford, VT DRAWING TITLE: Drawings Truss Type 2: Drawings DRAWN BY: JED CHECKED BY: JED/AD DATE: 4.30.09 | Renaud Bros. Construction 1000 Vermont Ave. (802) 257-1285 |
| SHEET NO.: T-2 | |
| 9 of 18 | |