

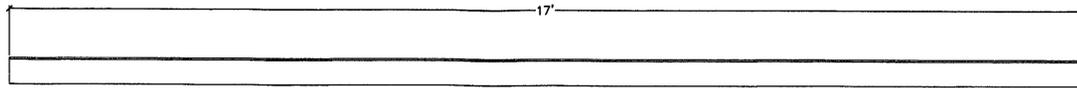
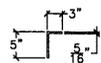


UPRIGHT MEMBERS:

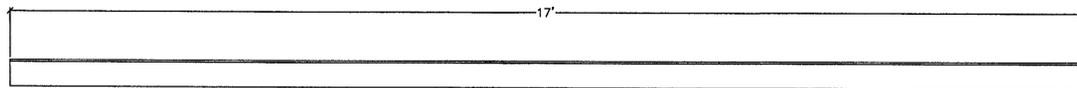

2DMO1-ANGLE
1-1/2" = 1'-0"

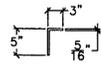

2DMO2-ANGLE
1-1/2" = 1'-0"

RECEIVED
 CK'D BY CHA OK'D BY _____
 MAY 11 2009
 BY WY APPROVED As Noted
 DATE 5/11/09

Renaud Bros. Construction Performance Vermont (802) 257-7300	
TITLE: Wallingford Bridge Rehab LOCATION: Wallingford, VT	DRAWING TITLE: Drawings Truss Type 2 Drawings DRAWN BY: SED CHECKED BY: SED/AD
JOB CONTACT: Erick Foster STATE: VT	DATE: 4.30.09
DRAWING NO: T-2	SHEET NO: 10 of 18