

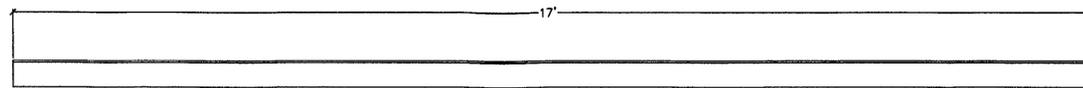
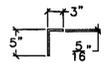


UPRIGHT MEMBERS:

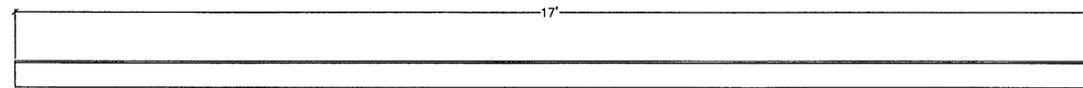

2DMO3-ANGLE
 $1-1/2'' = 1'-0''$

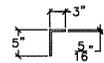

2DMO4-ANGLE
 $1-1/2'' = 1'-0''$

RECEIVED
 OK'D BY CHA OK'D BY _____
 MAY 11 2009
 APPROVED A. [Signature]
 BY WJ/SJ DATE 5/19/09

TITLE: Wallingford Bridge Rehab LOCATION: Wallingford, VT DRAWING TITLE: Drawings Truss Type 2: Drawings DRAWN BY: JED CHECKED BY: JED/AD JOB CONTACT: Erick Foster, State of VT DATE: 4 30 09	Renaud Bros. Construction Renaud Bros. Road (802) 257-7338
DRAWING NO.: SHEET NO.: T-2 11 OF 18	