


UPRIGHT MEMBERS:

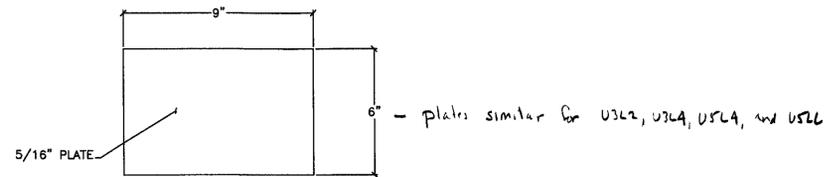

2DM05-PLATE
6" = 1'-0"

RECEIVED
CK'D BY CMA OK'D BY _____
MAY 11 2009
APPROVED [Signature]
BY SJA DATE 5/4/09
WY

FILE	Wallingford Bridge Rehab
LOCATION	Wallingford, VT
DRAWING TITLE	Drawings Truss Type 2. Drawings
DRAWN BY	JED
CHECKED BY	JED/AD
JOB CONTACT	Enck Foster State of VT
DATE	4 30 09
DRAWING NO.	T-2
SHEET NO.	12 OF 18

Pinard Bros. Construction
Rt. 100, Wallingford, VT 05491
(802) 257-7285