



BOTTOM CHORD:

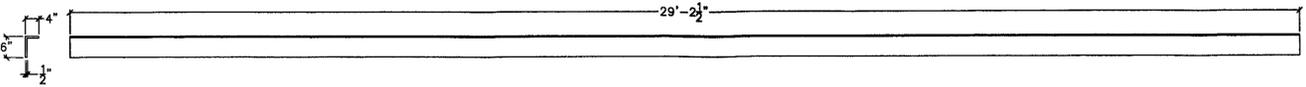

2L4L6A-ANGLE

1" = 1'-0"

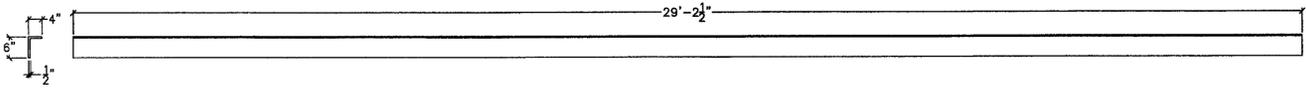

2L4L6B-ANGLE

1" = 1'-0"

RECEIVED
CK'D BY CMR OK'D BY _____

MAY 11 2011
APPROVED As Nabel
BY WY DATE 5/11/11

FILE	Wallingford Bridge Rehab
LOCATION	Wallingford, VT
DRAWING TITLE	Drawings Truss Type 2: Drawings
DRAWN BY	JED
CHECKED BY	ED/AD
DATE	4 30 09
JOB CONTACT	Erick Foster State of VT

DRAWING NO.	T-2
SHEET NO.	14 of 18