




GUSSET PLATES.:

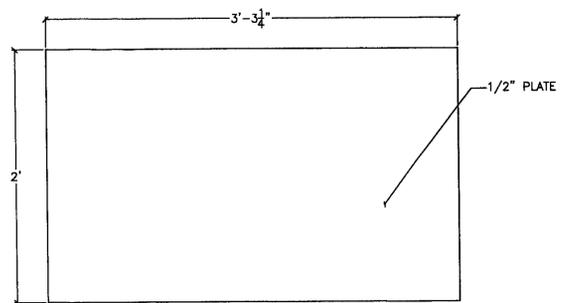

2GP01-PLATE
3" = 1'-0"

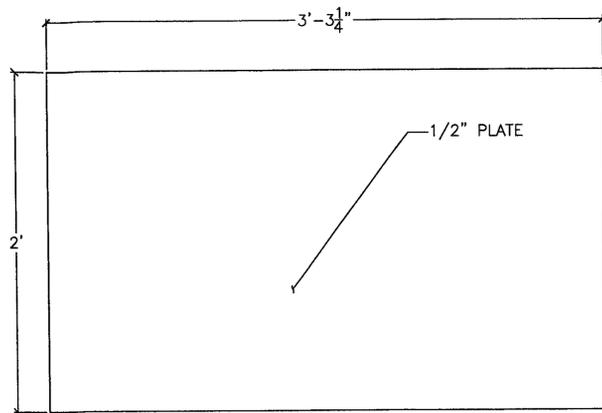

2GP02-PLATE
3" = 1'-0"

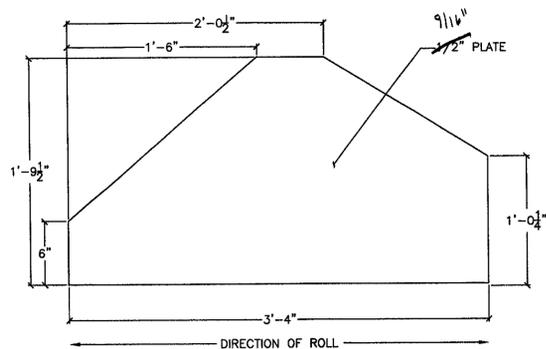

2GP03-PLATE
3" = 1'-0"

RECEIVED
 CK'D BY CHH OK'D BY _____
 MAY 11 2009
 R/SUBMIT _____ APPROVED AW
 BY WY DATE 5/11/09

Premium Brass Construction Hardware (802) 257-7353	
TITLE: Wallingford Bridge Rehab LOCATION: Wallingford, VT	DRAWING TITLE: Drawings Truss Type 2 Drawings DRAWN BY: JED JOB CONTACT: Erick Foster State of VT CHECKED BY: JED/AD DATE: 4 30 09
DRAWING NO.	T-2
SHEET NO.	17 of 18