



GUSSET PLATES.:

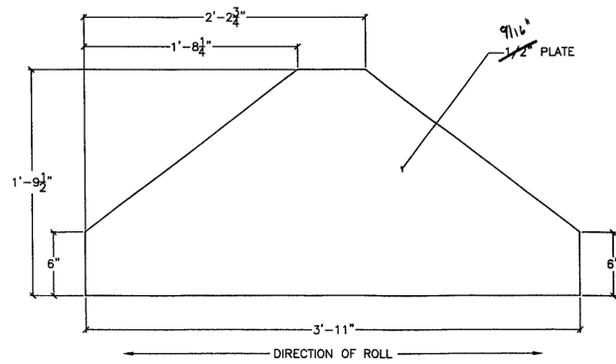

**2GP04-PLATE**  
3" = 1'-0"

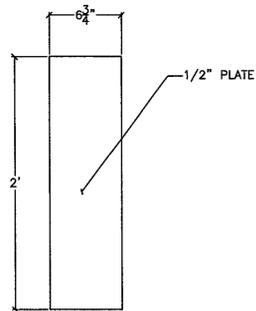

**2GP05-PLATE**  
3" = 1'-0"

RECEIVED  
 CK'D BY CJM OK'D BY \_\_\_\_\_  
 MAY 11 2009  
 RF SUEMIT \_\_\_\_\_ APPROVED As Noted  
 BY WY sp DATE 5/14/09

Renard Bros. Construction Regional Manager, 2004 (802) 257-1200	
TITLE	Wallingford Bridge Rehab
LOCATION	Wallingford, VT
DRAWING TITLE	Drawings Truss Type 2 Drawings
DRAWN BY	JED
CHECKED BY	ED/AD
JOB CONTRACT	Erick Foster State of VT
DATE	4.30.09
DRAWING NO.	T-2
SHEET NO.	18 of 18