


8 HORIZONTAL BRACES HB1

SHOP NOTE
TOE DIRECTION NEAR SIDE
LONG LEG SHOWN


DATE 6/3/09 BY [Signature]

CLDIGH HARBOUR & ASSOCIATES LLP
ENGINEERS ARCHITECTS INTERIORS & LANDSCAPE ARCHITECTS

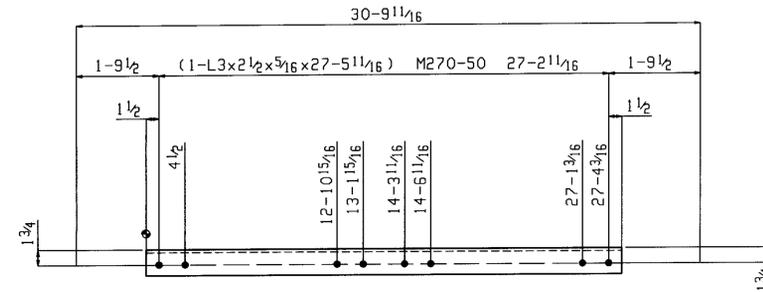


4 HORIZONTAL BRACES HB2


SHOP NOTE:
TOE DIRECTION FAR SIDE
LONG LEG SHOWN

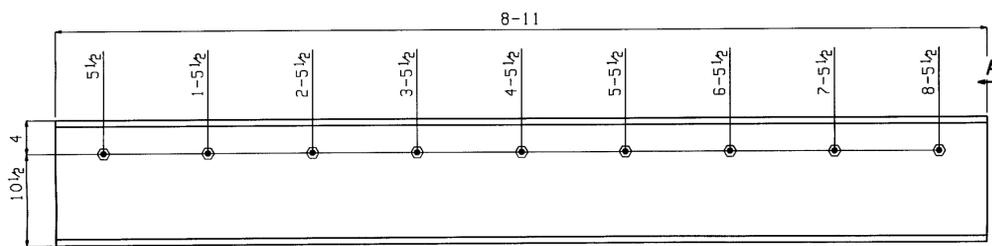


ONE MISC M1
GALV

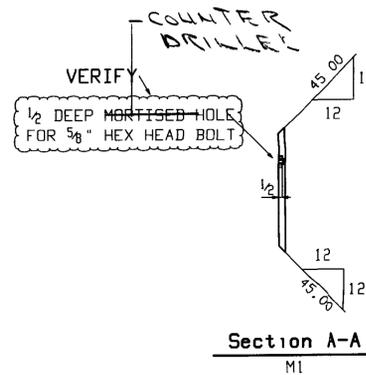

Section A-A
M1

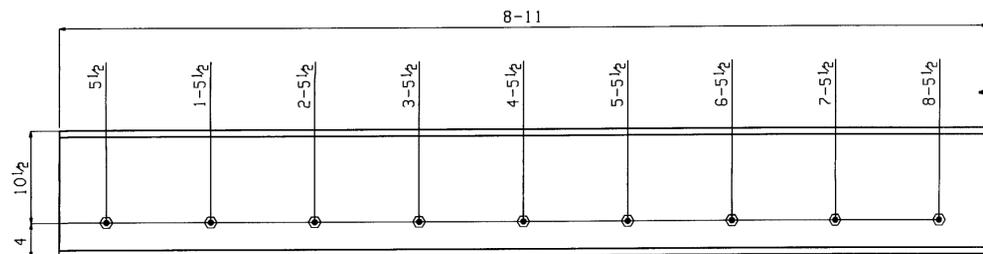

ONE MISC M2
GALV

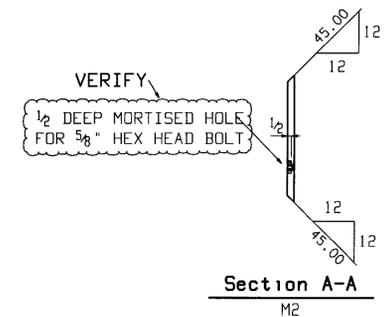

Section A-A
M2

BILL OF MATERIAL										BILL OF MATERIAL										BILL OF MATERIAL										
Qty	Piece				Seq	Seq	Adv	Steel		Qty	Piece				Seq	Seq	Adv	Steel		Qty	Piece				Seq	Seq	Adv	Steel		
Tot.	Mark	Description	Length	NO.	Qty	ABM #	Grade	Remarks		Tot.	Mark	Description	Length	NO.	Qty	ABM #	Grade	Remarks		Tot.	Mark	Description	Length	NO.	Qty	ABM #	Grade	Remarks		
8		HORIZONTAL BRACE		1	8					ONE	MISC			1	1				GALV											
8	HB1	L3x2 1/2 x 3 7/16	13	3 7/16			M270-50			1	M1	PL 3/4 x 14 1/2	8	11			M270-50													
4		HORIZONTAL BRACE		1	4					ONE	MISC			1	1				GALV											
4	HB2	L3x2 1/2 x 5 1/16	27	5 1/16			M270-50			1	M2	PL 3/4 x 14 1/2	8	11			M270-50													

Total weight 1832

RECEIVED
 OCT BY _____ OK'D BY _____
 MAY 26 2003
 RFSUBMIT _____ APPROVED _____
 BY _____ DATE _____

Renaud Bros. Inc.
 283 Fort Bridgeman Rd. #2
 Vernon, VT. 05354
 Phone 1-802 257-7383

Rev.No: _____ Date: _____
 Project: **WALLINGFORD BRIDGE** Date: 4-28-09 Job No. _____
 WALLINGFORD, VT DWN. BY EG Checked: _____ Sheet No. HB1-2, M1-2

MAY 15 2003 03:03:51 PM