



RAILING SYSTEM:

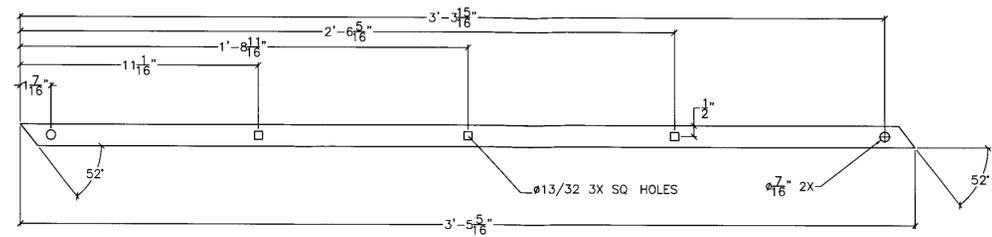

**HR01: PLATE-1/4"**  
 6" = 1'-0" QTY. 216

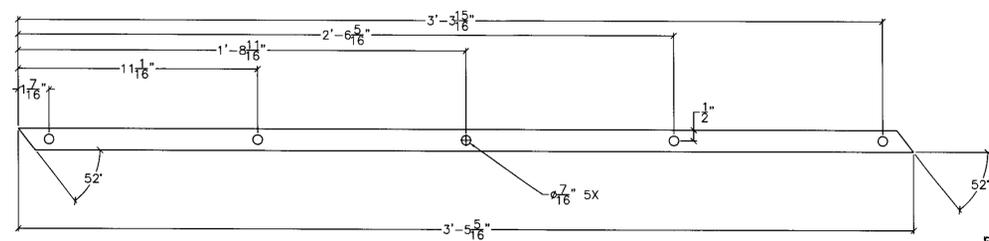

**HR02: PLATE-1/4"**  
 6" = 1'-0" QTY. 216

RECEIVED  
 CK'D BY \_\_\_\_\_ OK'D BY \_\_\_\_\_  
 JUL 31 2011  
 BY *W.A. 9/* APPROVED *[initials]*  
 DATE *8/1/11*

Renaud Bros. Construction Renaud Bros. Construction Renaud Bros. Construction (802) 257-7383	
LOCATION	Wallingford Bridge Rehab Wallingford, VT
DRAWING TITLE	Drawings Railing System Drawings
DRAWN BY	JED
CHECKED BY	Erick Foster State of VT
DATE	4 30 09
TITLE	Wallingford Bridge Rehab
DRAWING NO.	R-1
SHEET NO.	3 OF 10