



RAILNG SYSTEM:

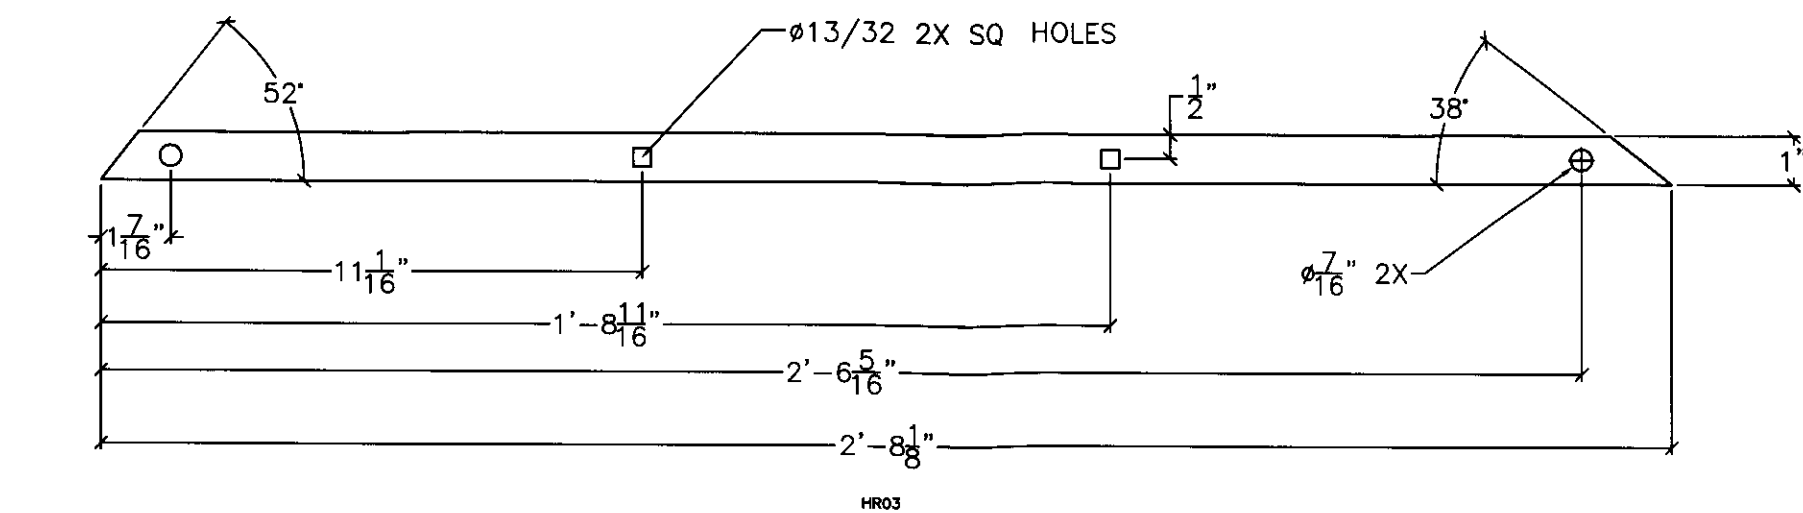

HR03: PLATE-1/4"
6" = 1'-0" QTY. 24

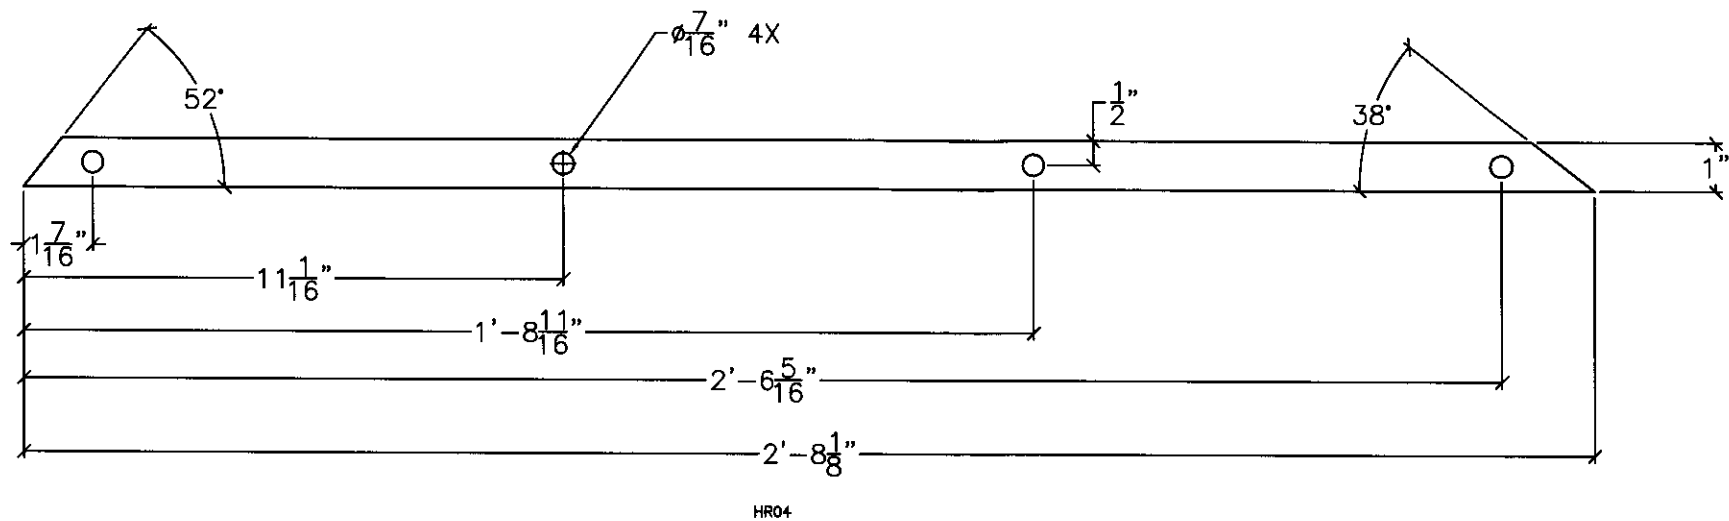

HR04: PLATE-1/4"
6" = 1'-0" QTY. 24

RECEIVED
JUL 3 12 21
BY *WY R. 3/* DATE *8/6/09*

Renard Bros. Construction Renaud Bros. Construction 1000 (802) 251-7255	
Wallingford Bridge Rehab Wallingford, VT	
Drawings Railing System Drawings	
DRAWN BY: JED	JOB CONTACT: Erick Foster State of VT
CHECKED BY: JED/AD	DATE: 4/30/09
R-1	
4 of 10	