




RAILING SYSTEM: FLARED END LEFT

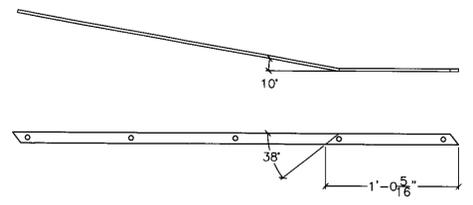


HRO21: LATTICE (USE HRO2)
 3" = 1'-0" QTY 2

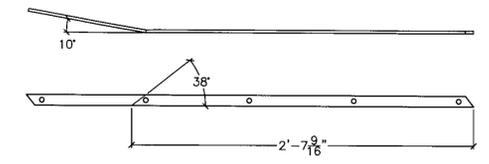

HRO22: LATTICE (USE HRO2)
 3" = 1'-0" QTY 2

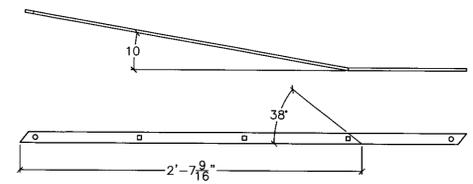

HRO11: -LATTICE(USE HRO1)
 3" = 1'-0" QTY 2

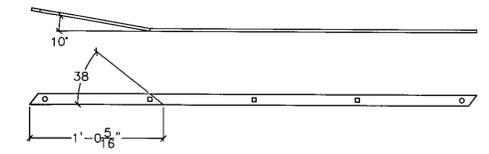

HRO12 -LATTICE (USE HRO1)
 3" = 1'-0" QTY 2

RECEIVED
 JUL 31 2009
 BY *WYB SJ* DATE *8/1/09*

Revised Base Construction Revised for (802) 257-7383
TITLE: Wallingford Bridge Rehab LOCATION: Wallingford, VT DRAWING TITLE: Drawings Railing System Drawings DRAWN BY: <i>sed</i> JOB CONTACT: Erick Foster State of VT CHECKED BY: <i>ED/AD</i> DATE: 4 30 09
DRAWING NO: R-1 SHEET NO: 7 OF 10