


RAILING SYSTEM:



HR101; 3/8 ROUND STOCK (USE HR10)

1" = 1'-0" QTY 12

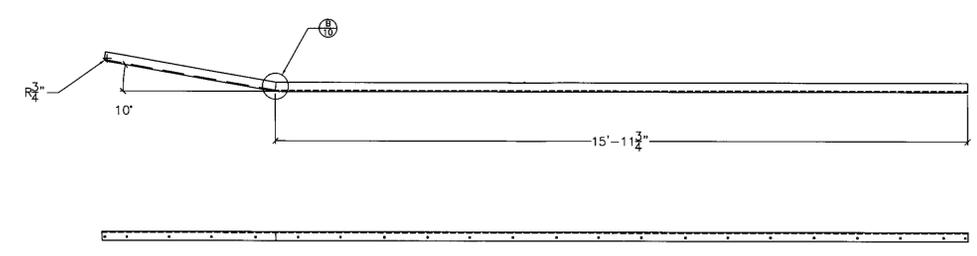

HR081,HR091; ANGLE (USE HR06)

1" = 1'-0" QTY 4

RECEIVED
 OK'D BY _____ OK'D BY _____
 JUL 31 2009
 BY *W.A.S.* DATE *8/2/09*

Renaud Bros Construction 1000 W. Main St. (802) 257-7383	
TITLE: Wallingford Bridge Rehab LOCATION: Wallingford, VT	DRAWING TITLE: Drawings Railing System Drawings DRAWN BY: JED JOB CONTACT: Erick Foster State of VT CHECKED BY: JED/AD DATE: 4/30/09
SHEET NO. 9 of 10	R-1