



RAILING SYSTEM:

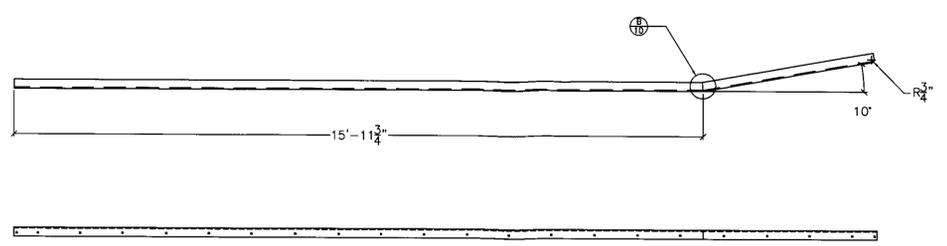


HR082, HR092: -ANGLE (USE HR07)
 1" = 1'-0" QTY 4

NOTES

- *RELIEF CUT TO BE MADE IN ANGLE, THEN BENT AND WELDED
- *BENDS TO BE PERFORMED COLD, ON A PRESS BRAKE

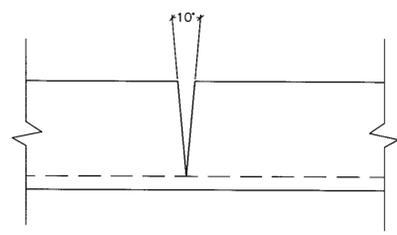

RELIEF CUT DETAIL
 1'-0"=1'-0"

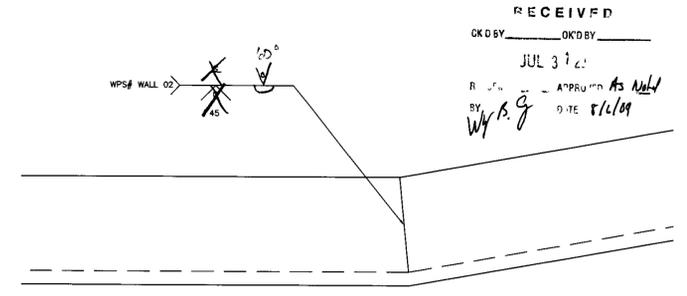

B
 10 WELD DETAIL AT FLARE
 1"=1"

RECEIVED
 OK'D BY _____ OK'D BY _____
 JUL 3 2009
 R. J. ... APPROVED As Noted
 BY: W.H.B.G. DATE 8/2/09

TITLE: Wallingford Bridge Rehab LOCATION: Wallingford, VT DRAWING TITLE: Drawings Railing System Drawings DRAWN BY: JED CHECKED BY: JED/AD DATE: 4/30/09	Prepared By: Construction Prepared By: JED/AD (802) 257-7283
DRAWING NO: R-1	SHEET NO: 10 of 10