


NO EXCEPTION TAKEN
 MAKE CORRECTIONS NOTED
 REJECTED
 REVISE AND RESUBMIT
 SUBMIT SPECIFIC ITEM

CHECKING IS ONLY FOR GENERAL CONFORMANCE WITH THE
 DESIGN CONCEPT OF THE PROJECT AND GENERAL
 COMPLIANCE WITH THE INFORMATION GIVEN IN THE
 CONTRACT DOCUMENTS. ANY ACTION SHOWN IS SUBJECT
 TO THE REQUIREMENTS OF THE PLANS AND SPECIFICATIONS.
 CONTRACTOR IS RESPONSIBLE FOR DIMENSIONS WHICH
 WILL BE CONFIRMED AND CORRELATED AT THE JOB SITE.
 ASSIGNMENT PROCESSES AND TECHNIQUES OF
 CONSTRUCTION; COORDINATION OF HIS WORK WITH THAT
 OF ALL OTHER TRADES AND THE SATISFACTORY
 PERFORMANCE OF HIS WORK.

GLENN HANCOCK ASSOCIATES
 PROJECT MANAGERS, PLANNERS
 AND DESIGNERS

6/3/09

[Handwritten signature]

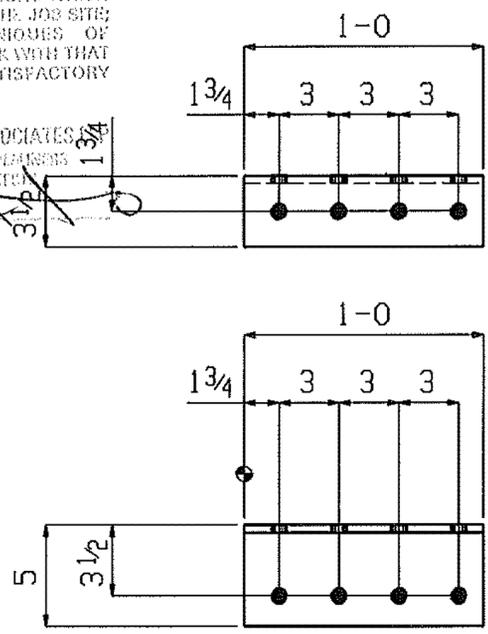

18 L5x3 1/2 x 3/8 x 1-0 a1

GRADE: M270-50

RECEIVED

OK'D BY _____ OK'D BY _____

MAY 26 2009

RESUBMIT _____ APPROVED _____

BY _____ DATE _____

Renaud Bros. Inc.
 283 Fort Bridgeman Rd. #2
 Vernon, VT. 05354
 Phone 1-802 257-7383

JOB: WALLINGFORD BRIDGE		PART	
WALLINGFORD, VT			
BOLTS: 3/4" DIA. M164-I GALV	STL GR: M270-50 UNO	DRWN BY: EG	DATE: 5-11-09
HOLE:	1 3/16 UNO	CHK:	JOB NO:
			a1

May 15 2009 03:07:50 PM