


NO EXCEPTION TAKEN
 MAKE CORRECTIONS NOTED
 REVISIT
 REVISE AND RESUBMIT
 SUBMIT SPECIFIED ITEM

CHECKING IS ONLY FOR GENERAL CONFORMANCE WITH THE
 INTENT CONCEPT OF THE PROJECT AND GENERAL
 CONFORMANCE WITH THE INFORMATION GIVEN IN THE
 CONTRACT DOCUMENTS. ANY ACTION SHOWN IS SUBJECT
 TO THE REQUIREMENTS OF THE PLANS AND SPECIFICATIONS.
 THE CONTRACTOR IS RESPONSIBLE FOR DIMENSIONS WHICH
 ARE NOT SPECIFIED AND CORRELATED AT THE JOB SITE;
 THE CONTRACTOR IS RESPONSIBLE FOR THE SELECTION OF
 MATERIALS, PROCESSES AND TECHNIQUES OF
 CONSTRUCTION, COORDINATION OF HIS WORK WITH THAT
 OF OTHER TRADES AND THE SATISFACTORY
 PERFORMANCE OF HIS WORK.

CLEGG HARBOUR & ASSOCIATES LLP
 ENGINEERS, SURVEYORS, PLANNERS
 LANDSCAPE ARCHITECTS

6/2/09

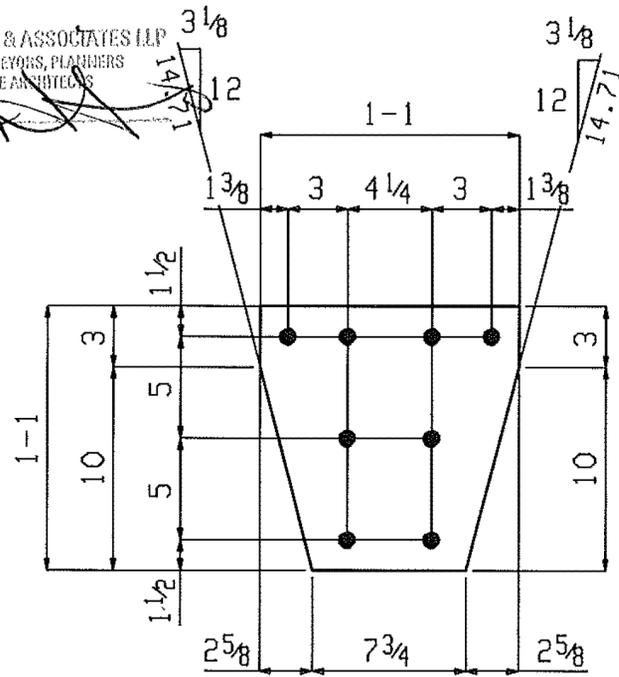

8 PL 1/2 x 13 x 1-1 p17

GRADE: M270-50

Renaud Bros. Inc.

283 Fort Bridgeman Rd. #2
 Vernon, VT. 05354
 Phone 1-802 257-7383

JOB: WALLINGFORD BRIDGE		PART	
WALLINGFORD, VT			
BOLTS: 3/4" DIA. M164-1 GALV	STL GR: M270-50 UNO	DRWN BY: EG	DATE: 5-11-09
	HOLES: 13/16 UNO	CHK:	JOB NO:
			SHT: p17

May 15 2009 03:08:08 PM