


SEE SHEET 2 FOR INDEX OF SHEETS

STATE OF VERMONT
AGENCY OF TRANSPORTATION

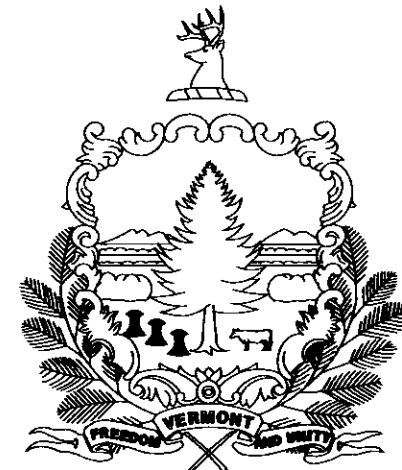


PROPOSED IMPROVEMENT
BRIDGE PROJECT
TOWN OF WALLINGFORD
COUNTY OF RUTLAND

ROUTE NO : PEDESTRIAN BRIDGE BRIDGE NO : ADAPTIVE REUSE

PROJECT LOCATION: LOCATED IN THE COUNTY OF RUTLAND, TOWN OF WALLINGFORD,
PEDESTRIAN BRIDGE OVER THE OTTER CREEK, APPROXIMATELY 800+/- FEET
SOUTH OF VT. ROUTE 140 BETWEEN WALDO LANE AND THE WALLINGFORD TOWN PARK.


PROJECT DESCRIPTION: REHABILITATE AND ASSEMBLE HISTORIC TRUSS OVER OTTER CREEK AT THE WALLINGFORD TOWN PARK.

LENGTH OF STRUCTURE : 120.91 FEET
LENGTH OF APPROACH: 154.01 FEET
LENGTH OF PROJECT: 274.92 FEET

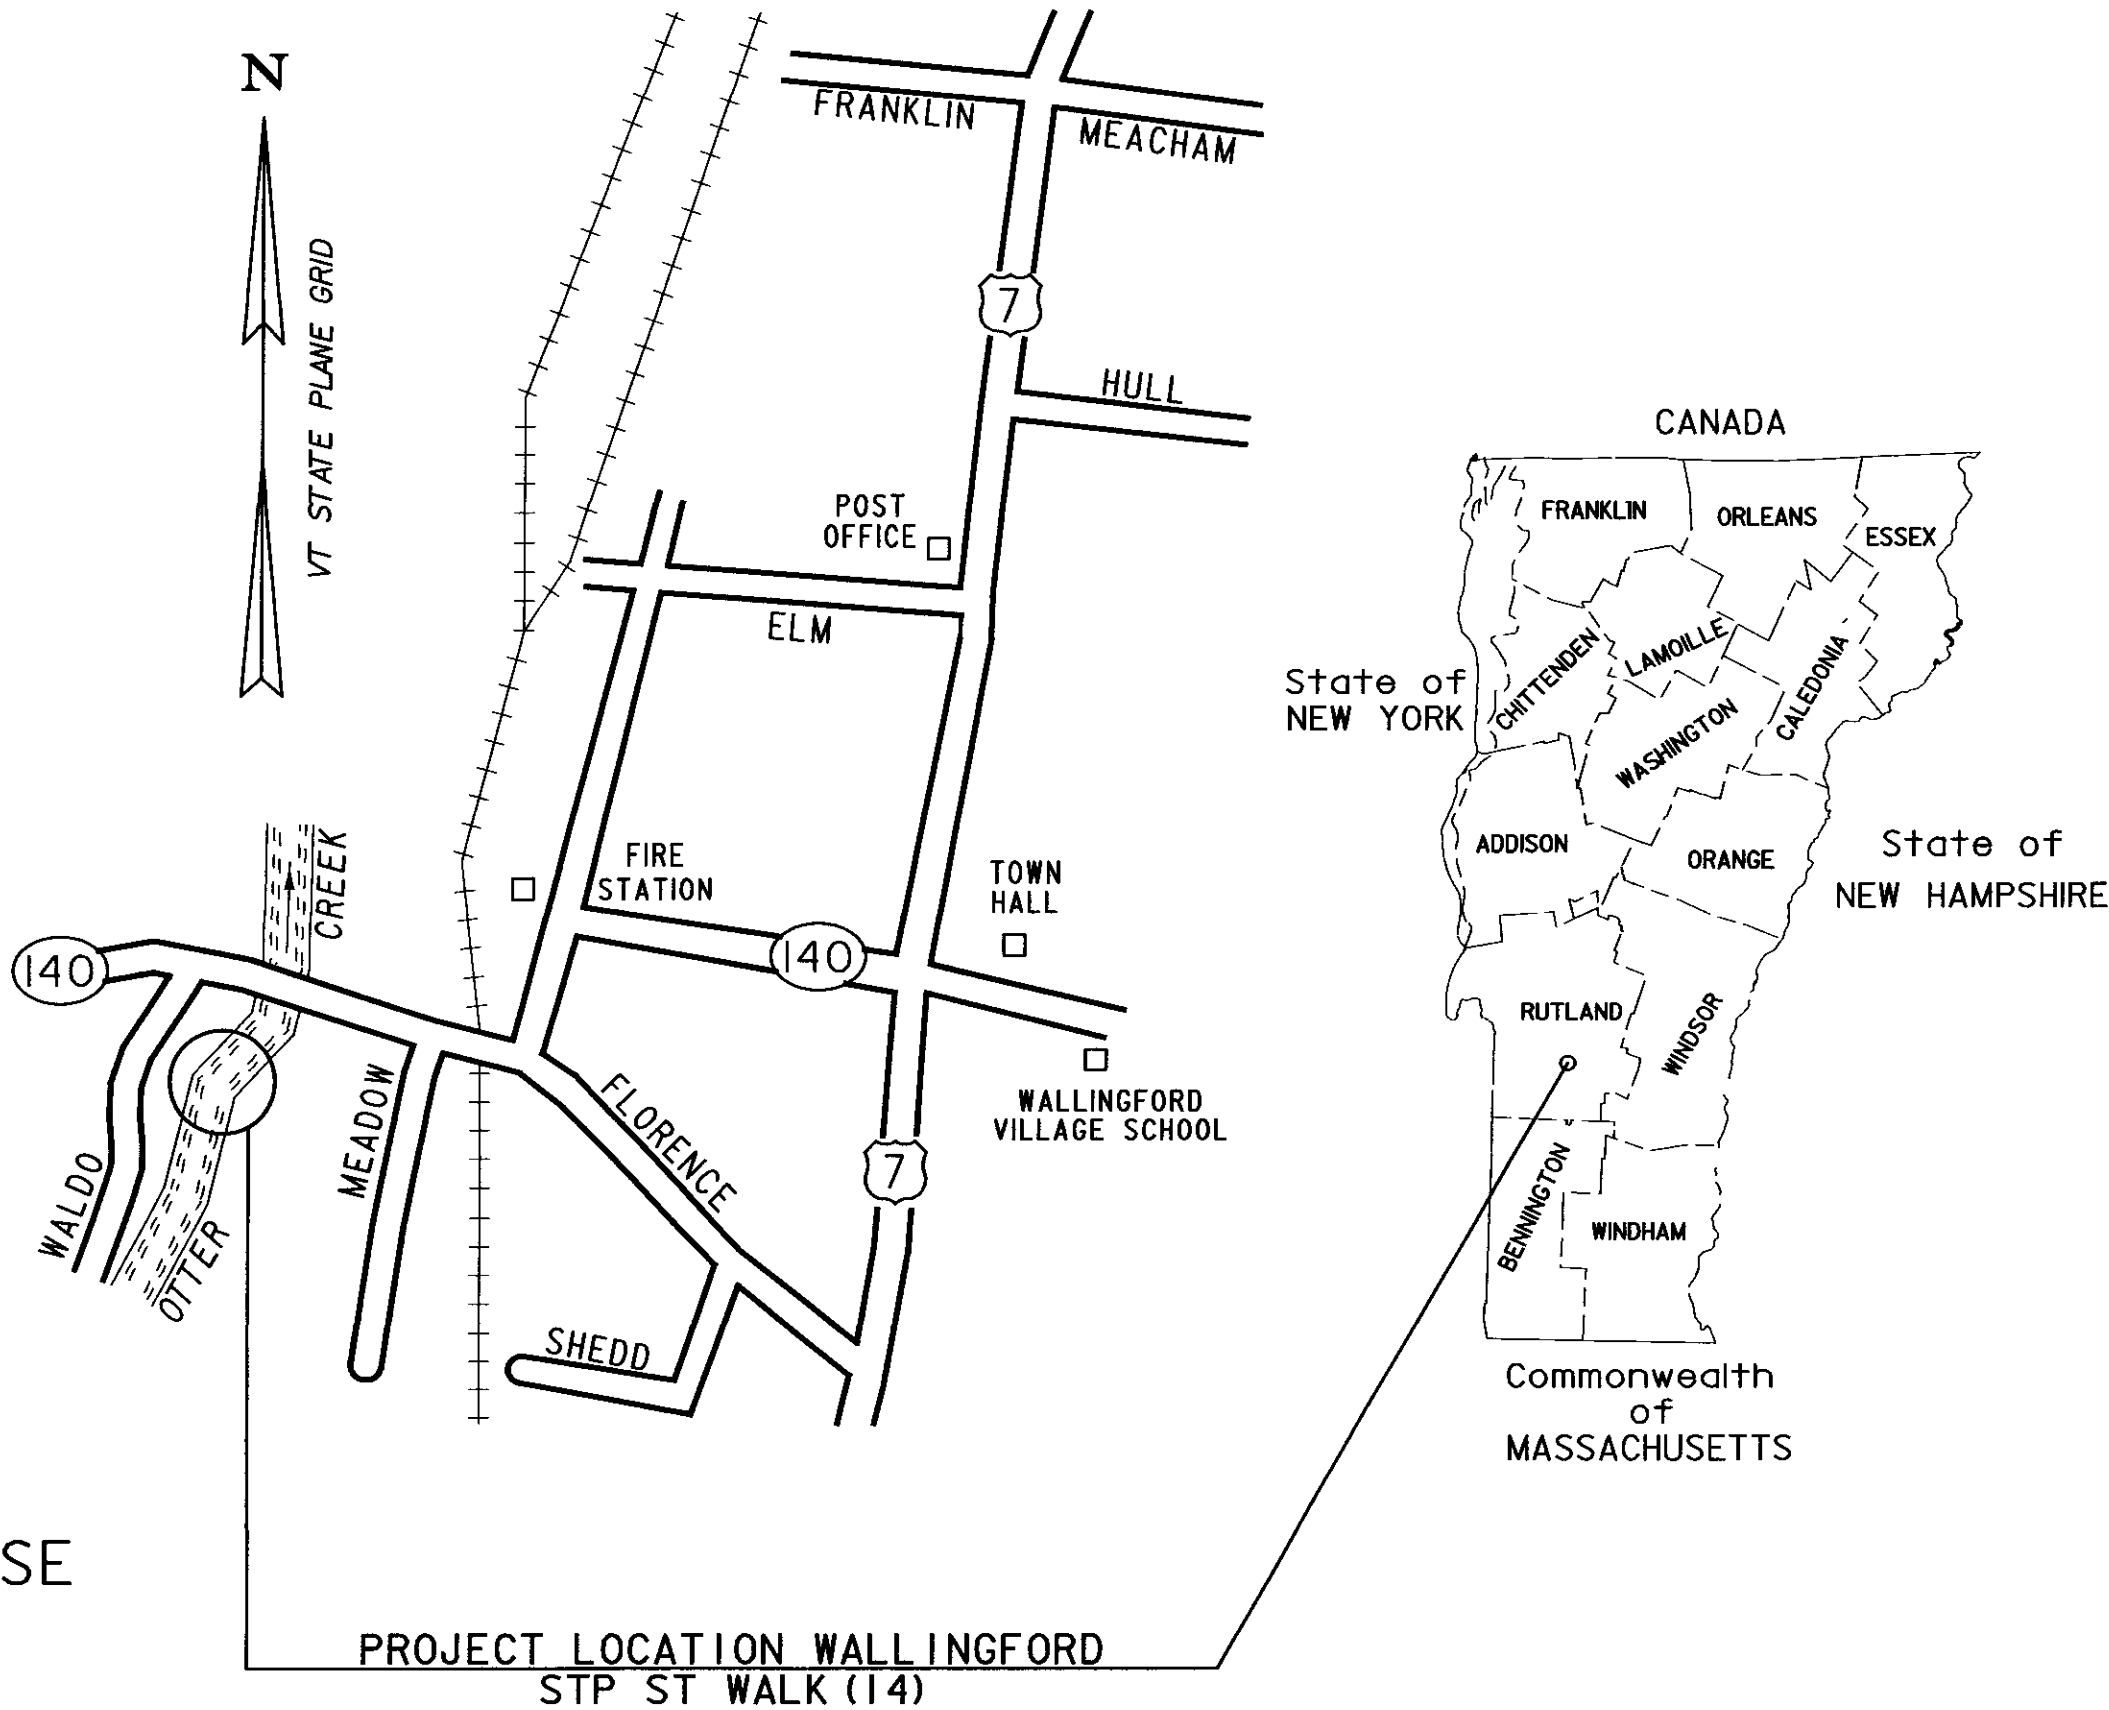

CONVENTIONAL SYMBOLS

COUNTY LINE	
TOWN LINE	
LIMITS OF ACCESS	
POINT OF ACCESS	
FENCE LINE	
STONE WALL	
TRAVELED WAY	
GUARD RAIL	
RAILROAD	
SURVEY LINE	
CULVERT	
POWER POLE	
TELEPHONE POLE	
TREES	
CONTROL OF ACCESS	
PROPERTY LINE	
R.O.W. TAKING LINE	
SLOPE RIGHTS	
TOP OF CUT	
TOE OF SLOPE	

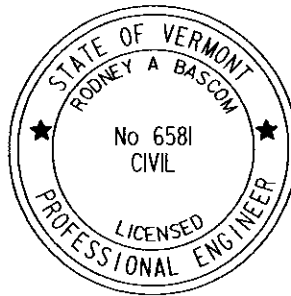


PLANS PREPARED BY

Richard J. Brouse

CHA

DATUM

VERTICAL NAVD 88
HORIZONTAL NAD 83 (92)

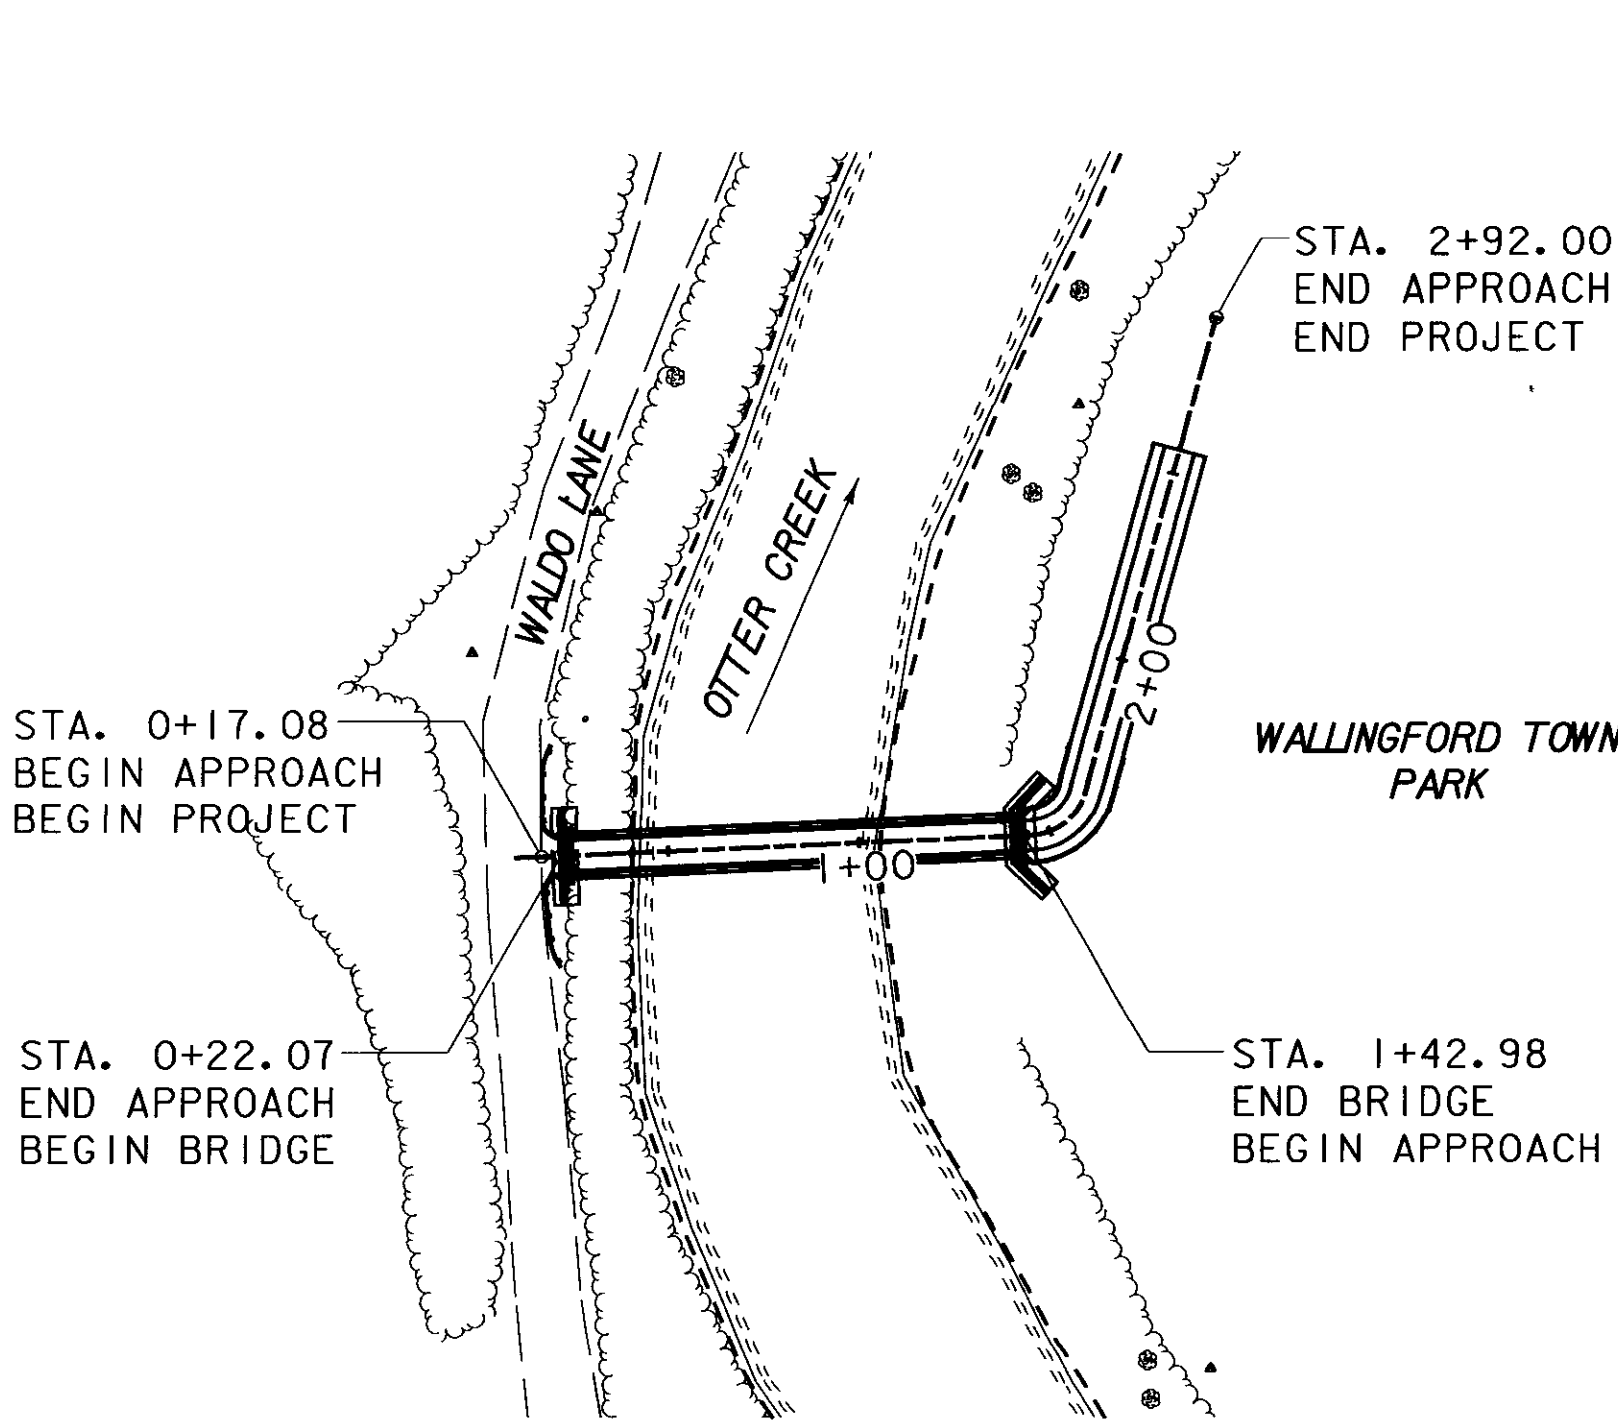

SCALE 1" = 50'



RECORD PLANS

CONTRACTOR RENAUD BROTHERS, INC - VERNON, VT

RESIDENT ENGINEER ERIC FOSTER

CONSTRUCTION BEGAN APRIL 10, 2009

CONSTRUCTION COMPLETE NOVEMBER 18, 2009

RECORD PLANS BY ERIC FOSTER & NICK GARBACIK

I HEREBY CERTIFY THAT ALL THE CONSTRUCTION REQUIRED BY THIS SET OF DRAWINGS HAS BEEN ACCOMPLISHED AS INDICATED HEREIN

BY *Eric Foster* RESIDENT ENGINEER

DATE 10 25 2010

NOTE Any further information concerning final quantities, amounts or other details relative to this project may be found at Central Files in the electronic archives (OnBase)

THESE PLANS ARE SUBJECT TO SUCH ENGINEERING CHANGES AS MAY BE REQUIRED BY THE FEDERAL HIGHWAY ADMINISTRATION OR THE DIRECTOR OF PROGRAM DEVELOPMENT.

CONSTRUCTION IS TO BE CARRIED ON IN ACCORDANCE WITH THESE PLANS AND THE STANDARD SPECIFICATIONS FOR CONSTRUCTION DATED 2006, AS APPROVED BY THE FEDERAL HIGHWAY ADMINISTRATION ON JUNE 15, 2006 FOR USE ON THIS PROJECT, INCLUDING ALL SUBSEQUENT REVISIONS AND SUCH REVISED SPECIFICATIONS AND SPECIAL PROVISIONS AS ARE INCORPORATED IN THESE PLANS.

DIRECTOR OF PROGRAM DEVELOPMENT

APPROVED *Richard J. Brouse* DATE 1-13-09

PROJECT MANAGER : SUSAN SCRIBNER

PROJECT NAME : WALLINGFORD
PROJECT NUMBER : STP ST WALK (14)

SHEET 1 OF 26 SHEETS