
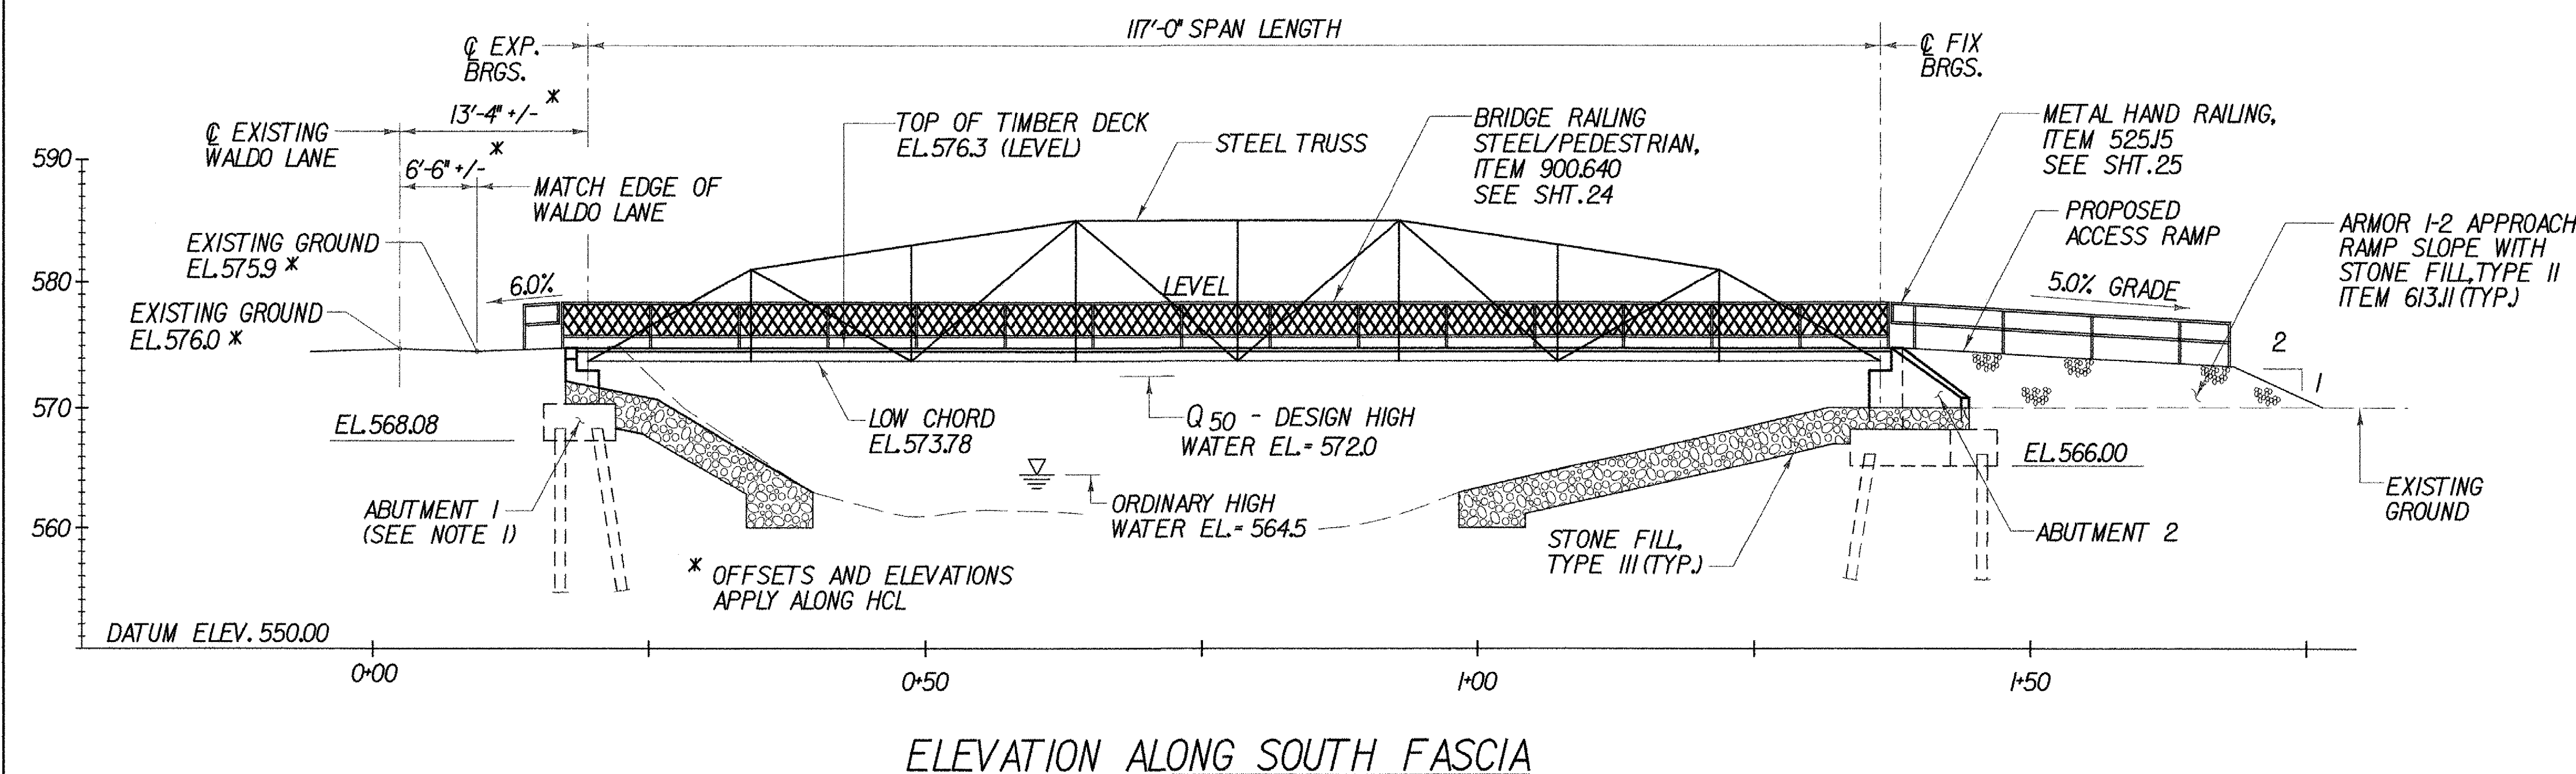
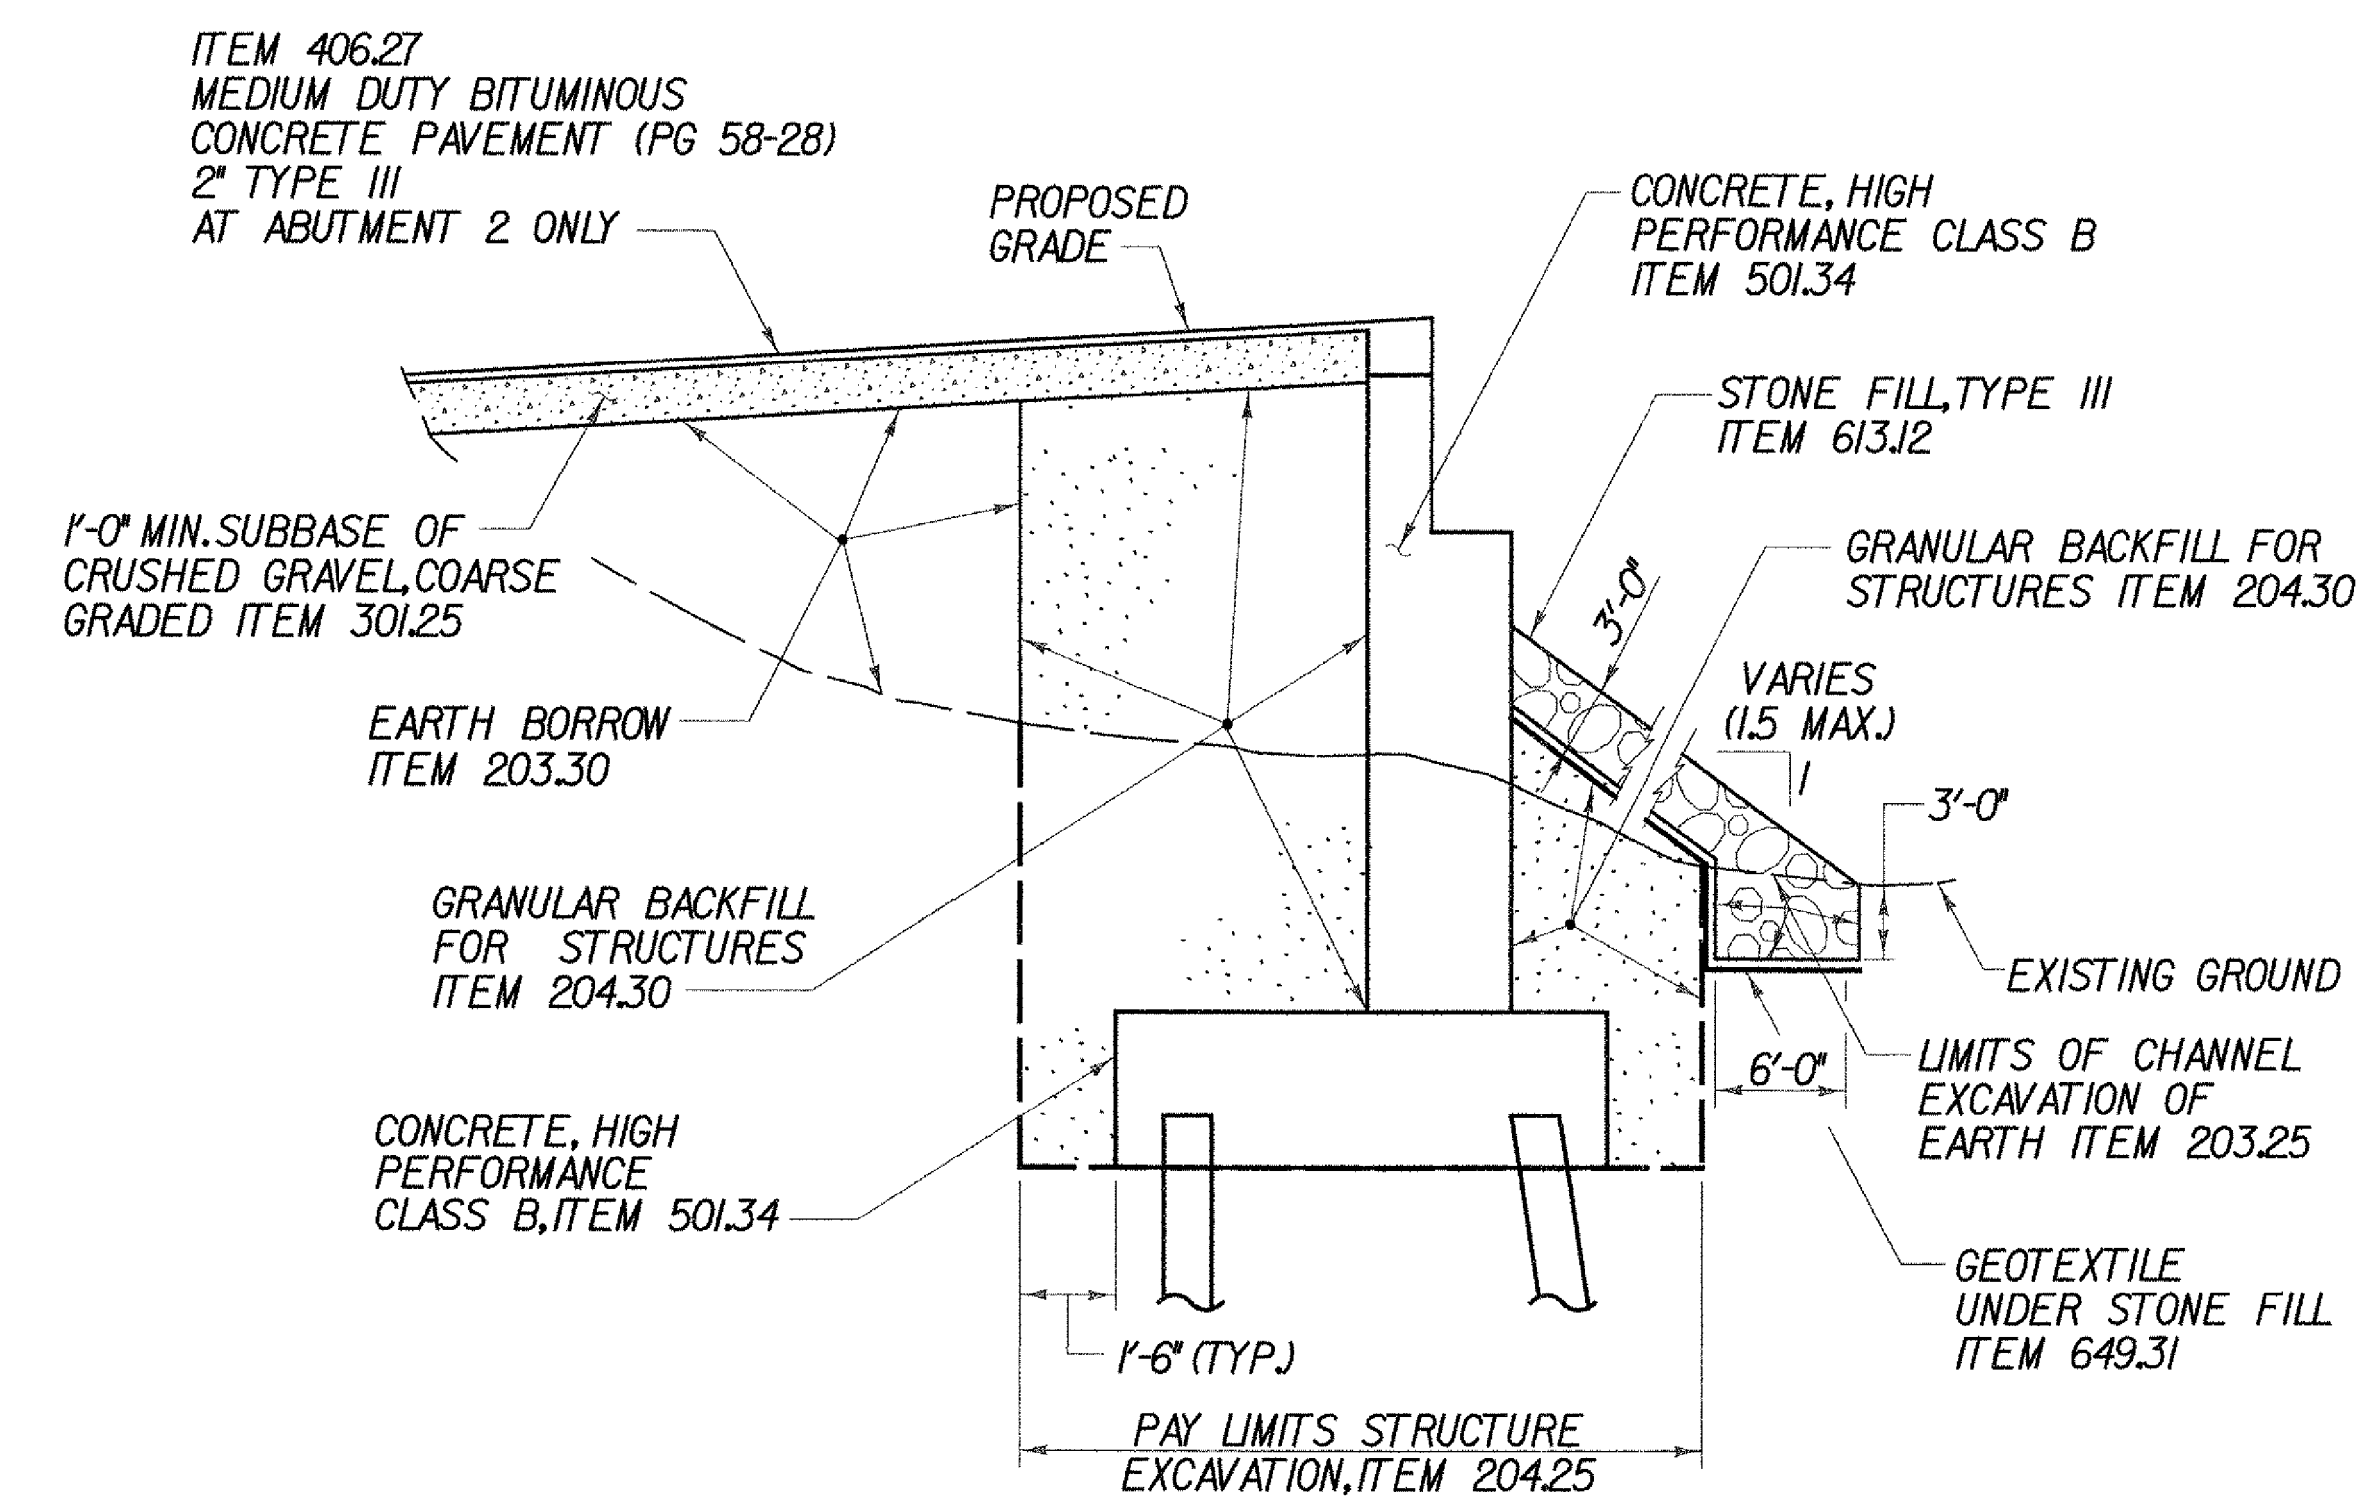
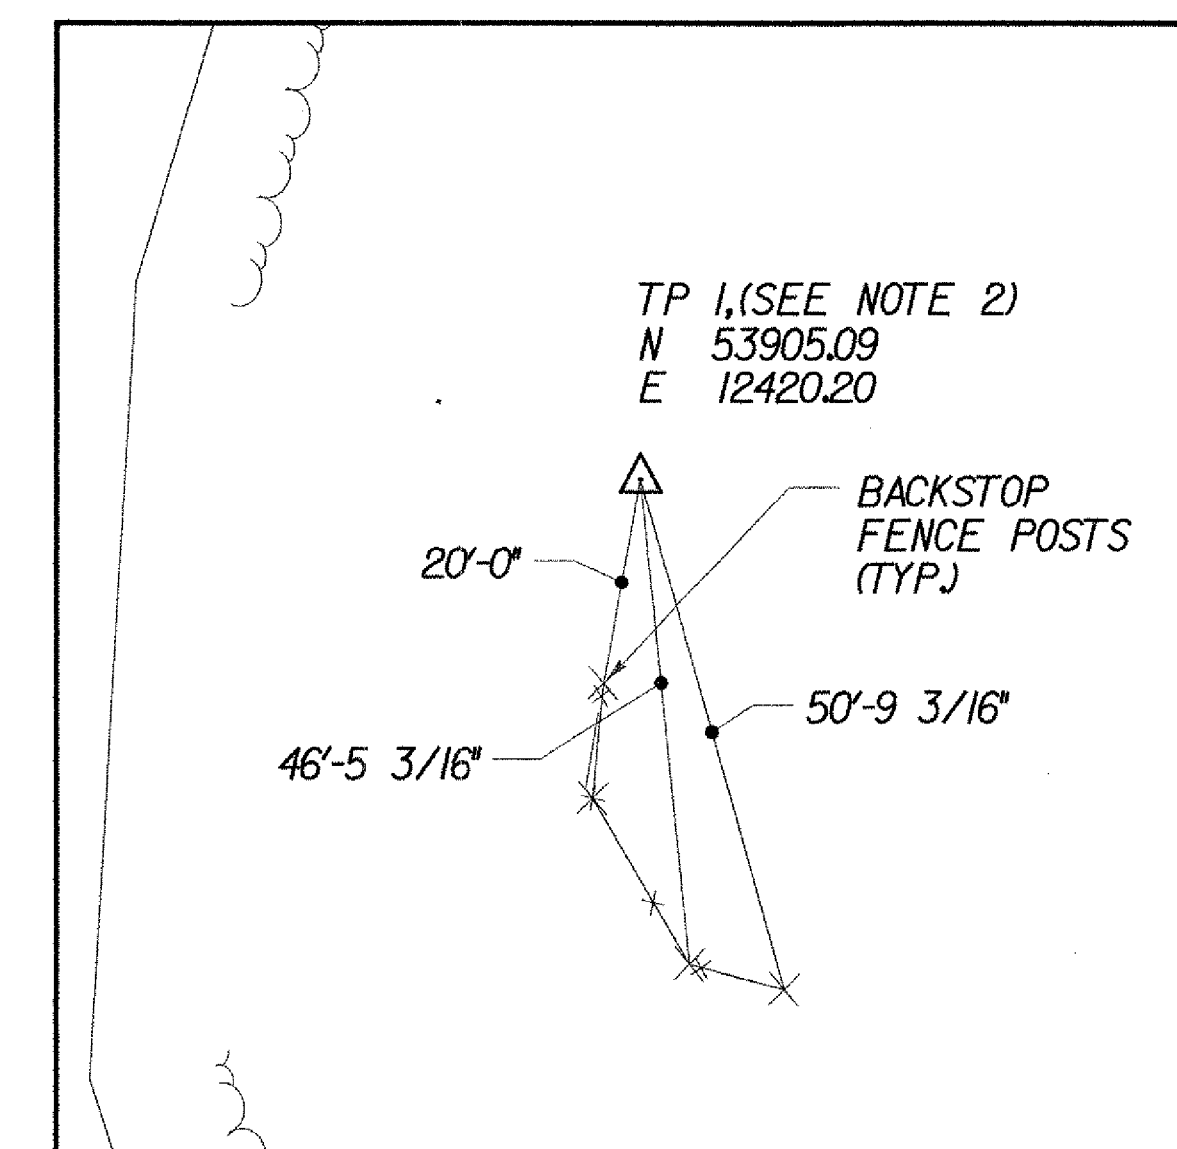
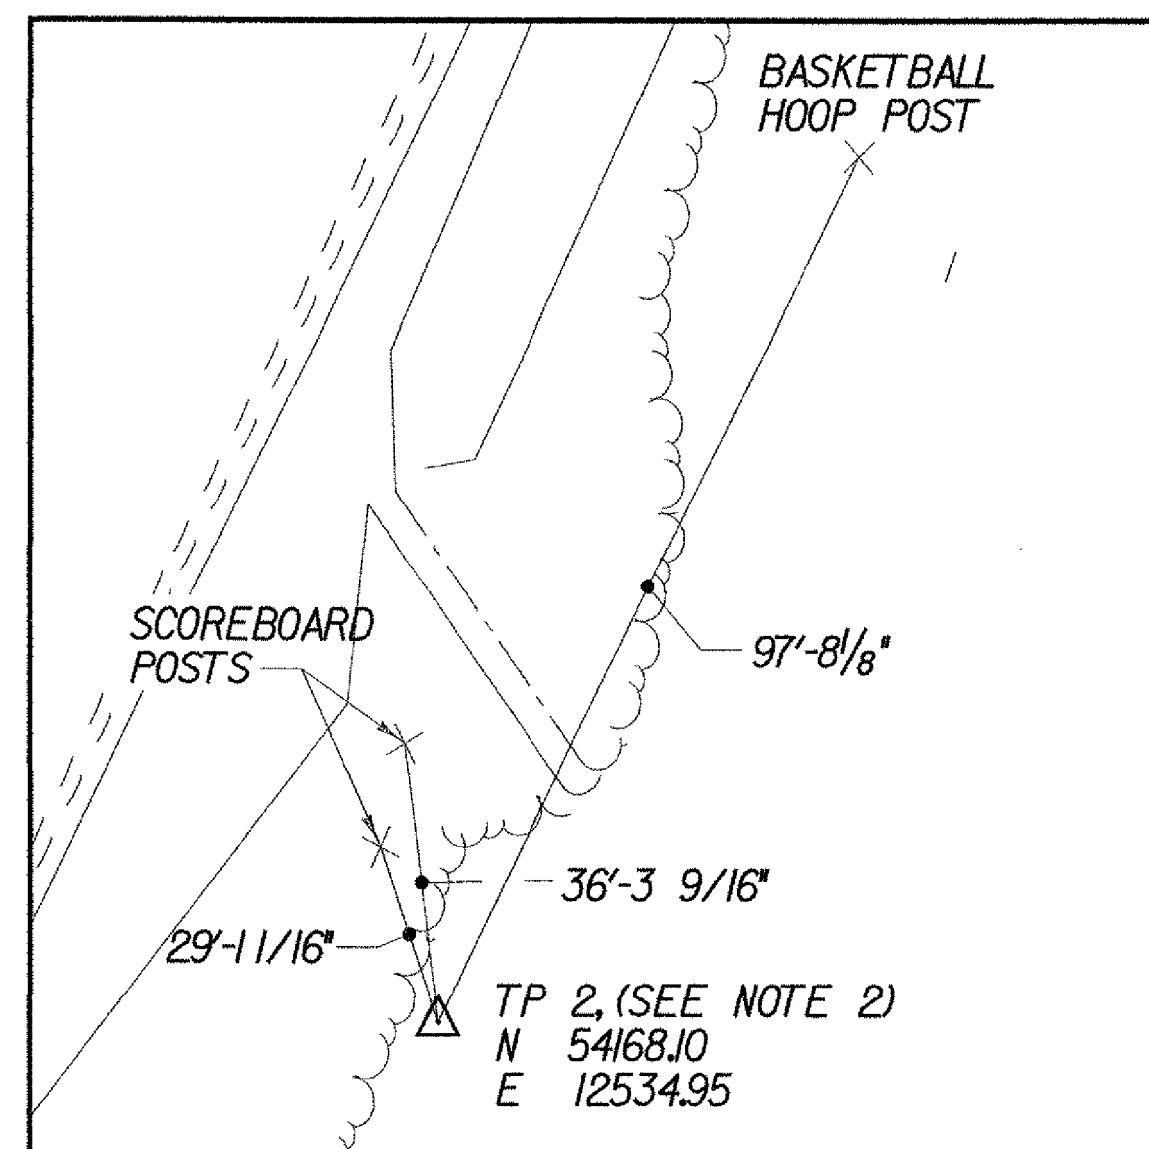


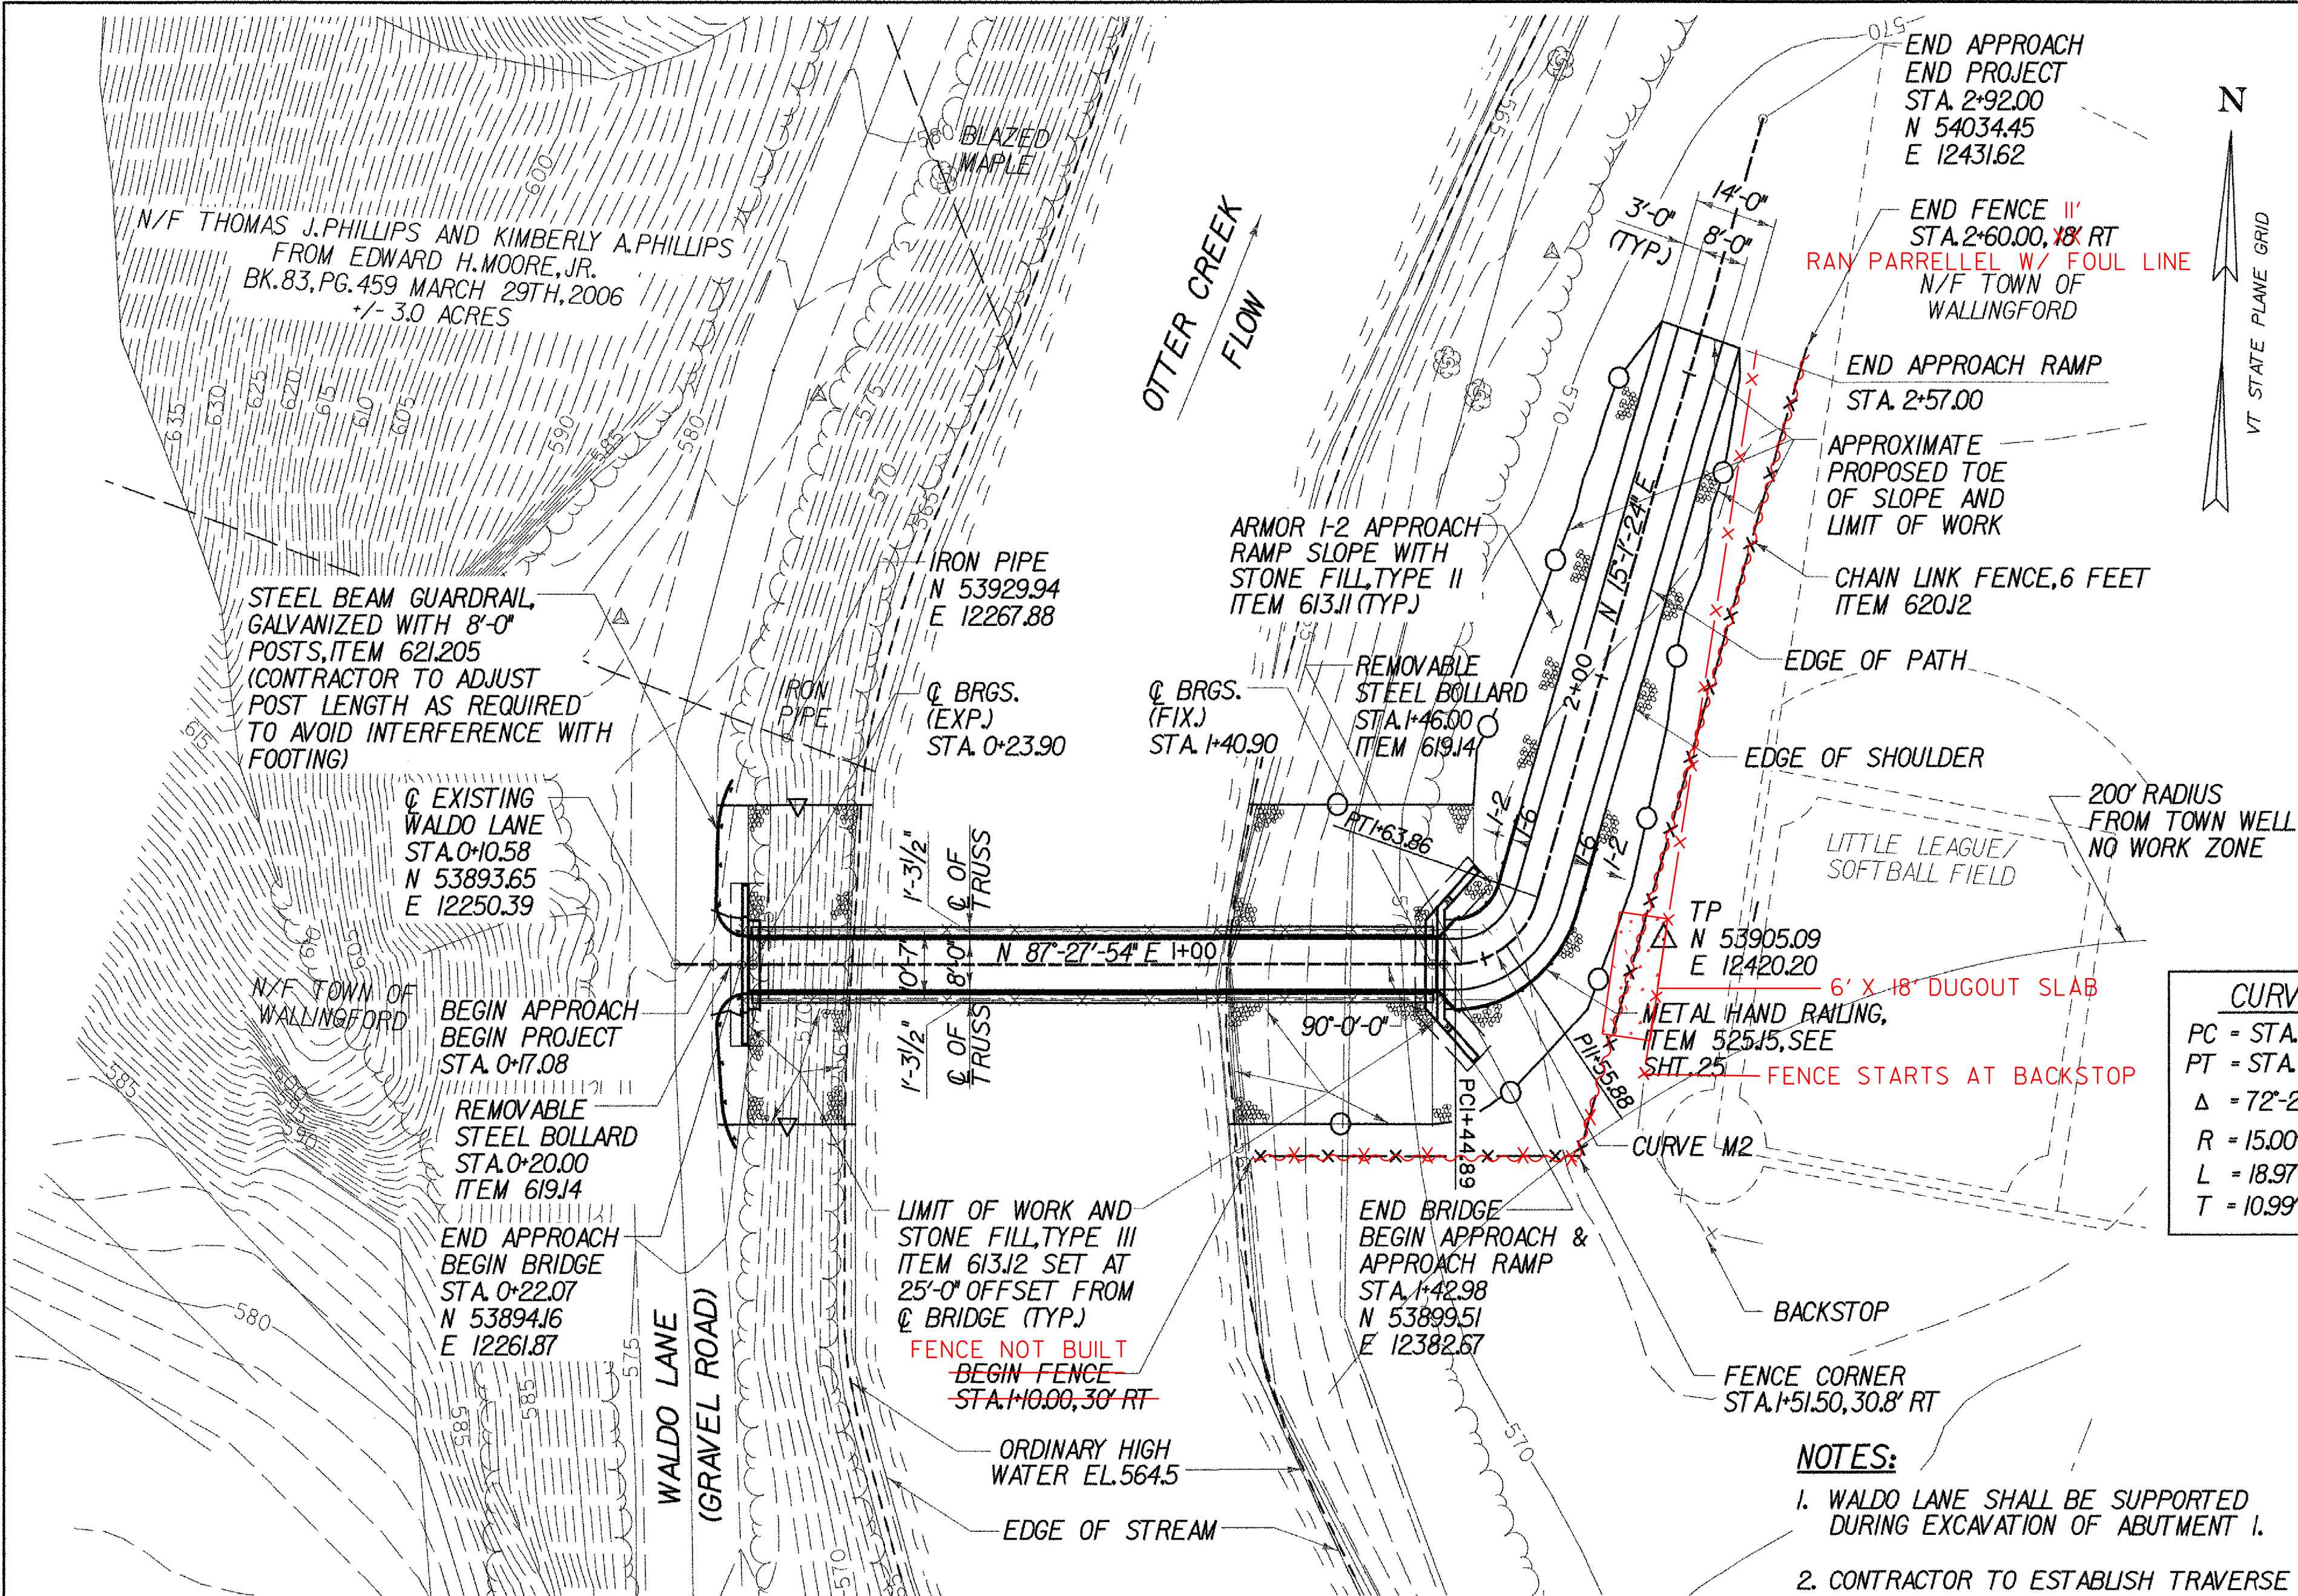

PLAN AND ELEVATION

PROJECT NAME: WALLINGFORD
PROJECT NUMBER: STP ST WALK(14)

FILE NAME: \$FILES\$
PROJECT MANAGER: SUSAN SCRIBNER
DESIGNED BY: L. HARDEN
BRIDGE DESIGN SUPERVISOR: P. HALSTEAD

PLOT DATE: 1/9/2009
DRAWN BY: W. WEATHERBY
CHECKED BY: P. HALSTEAD
SHEET 16 OF 26

