



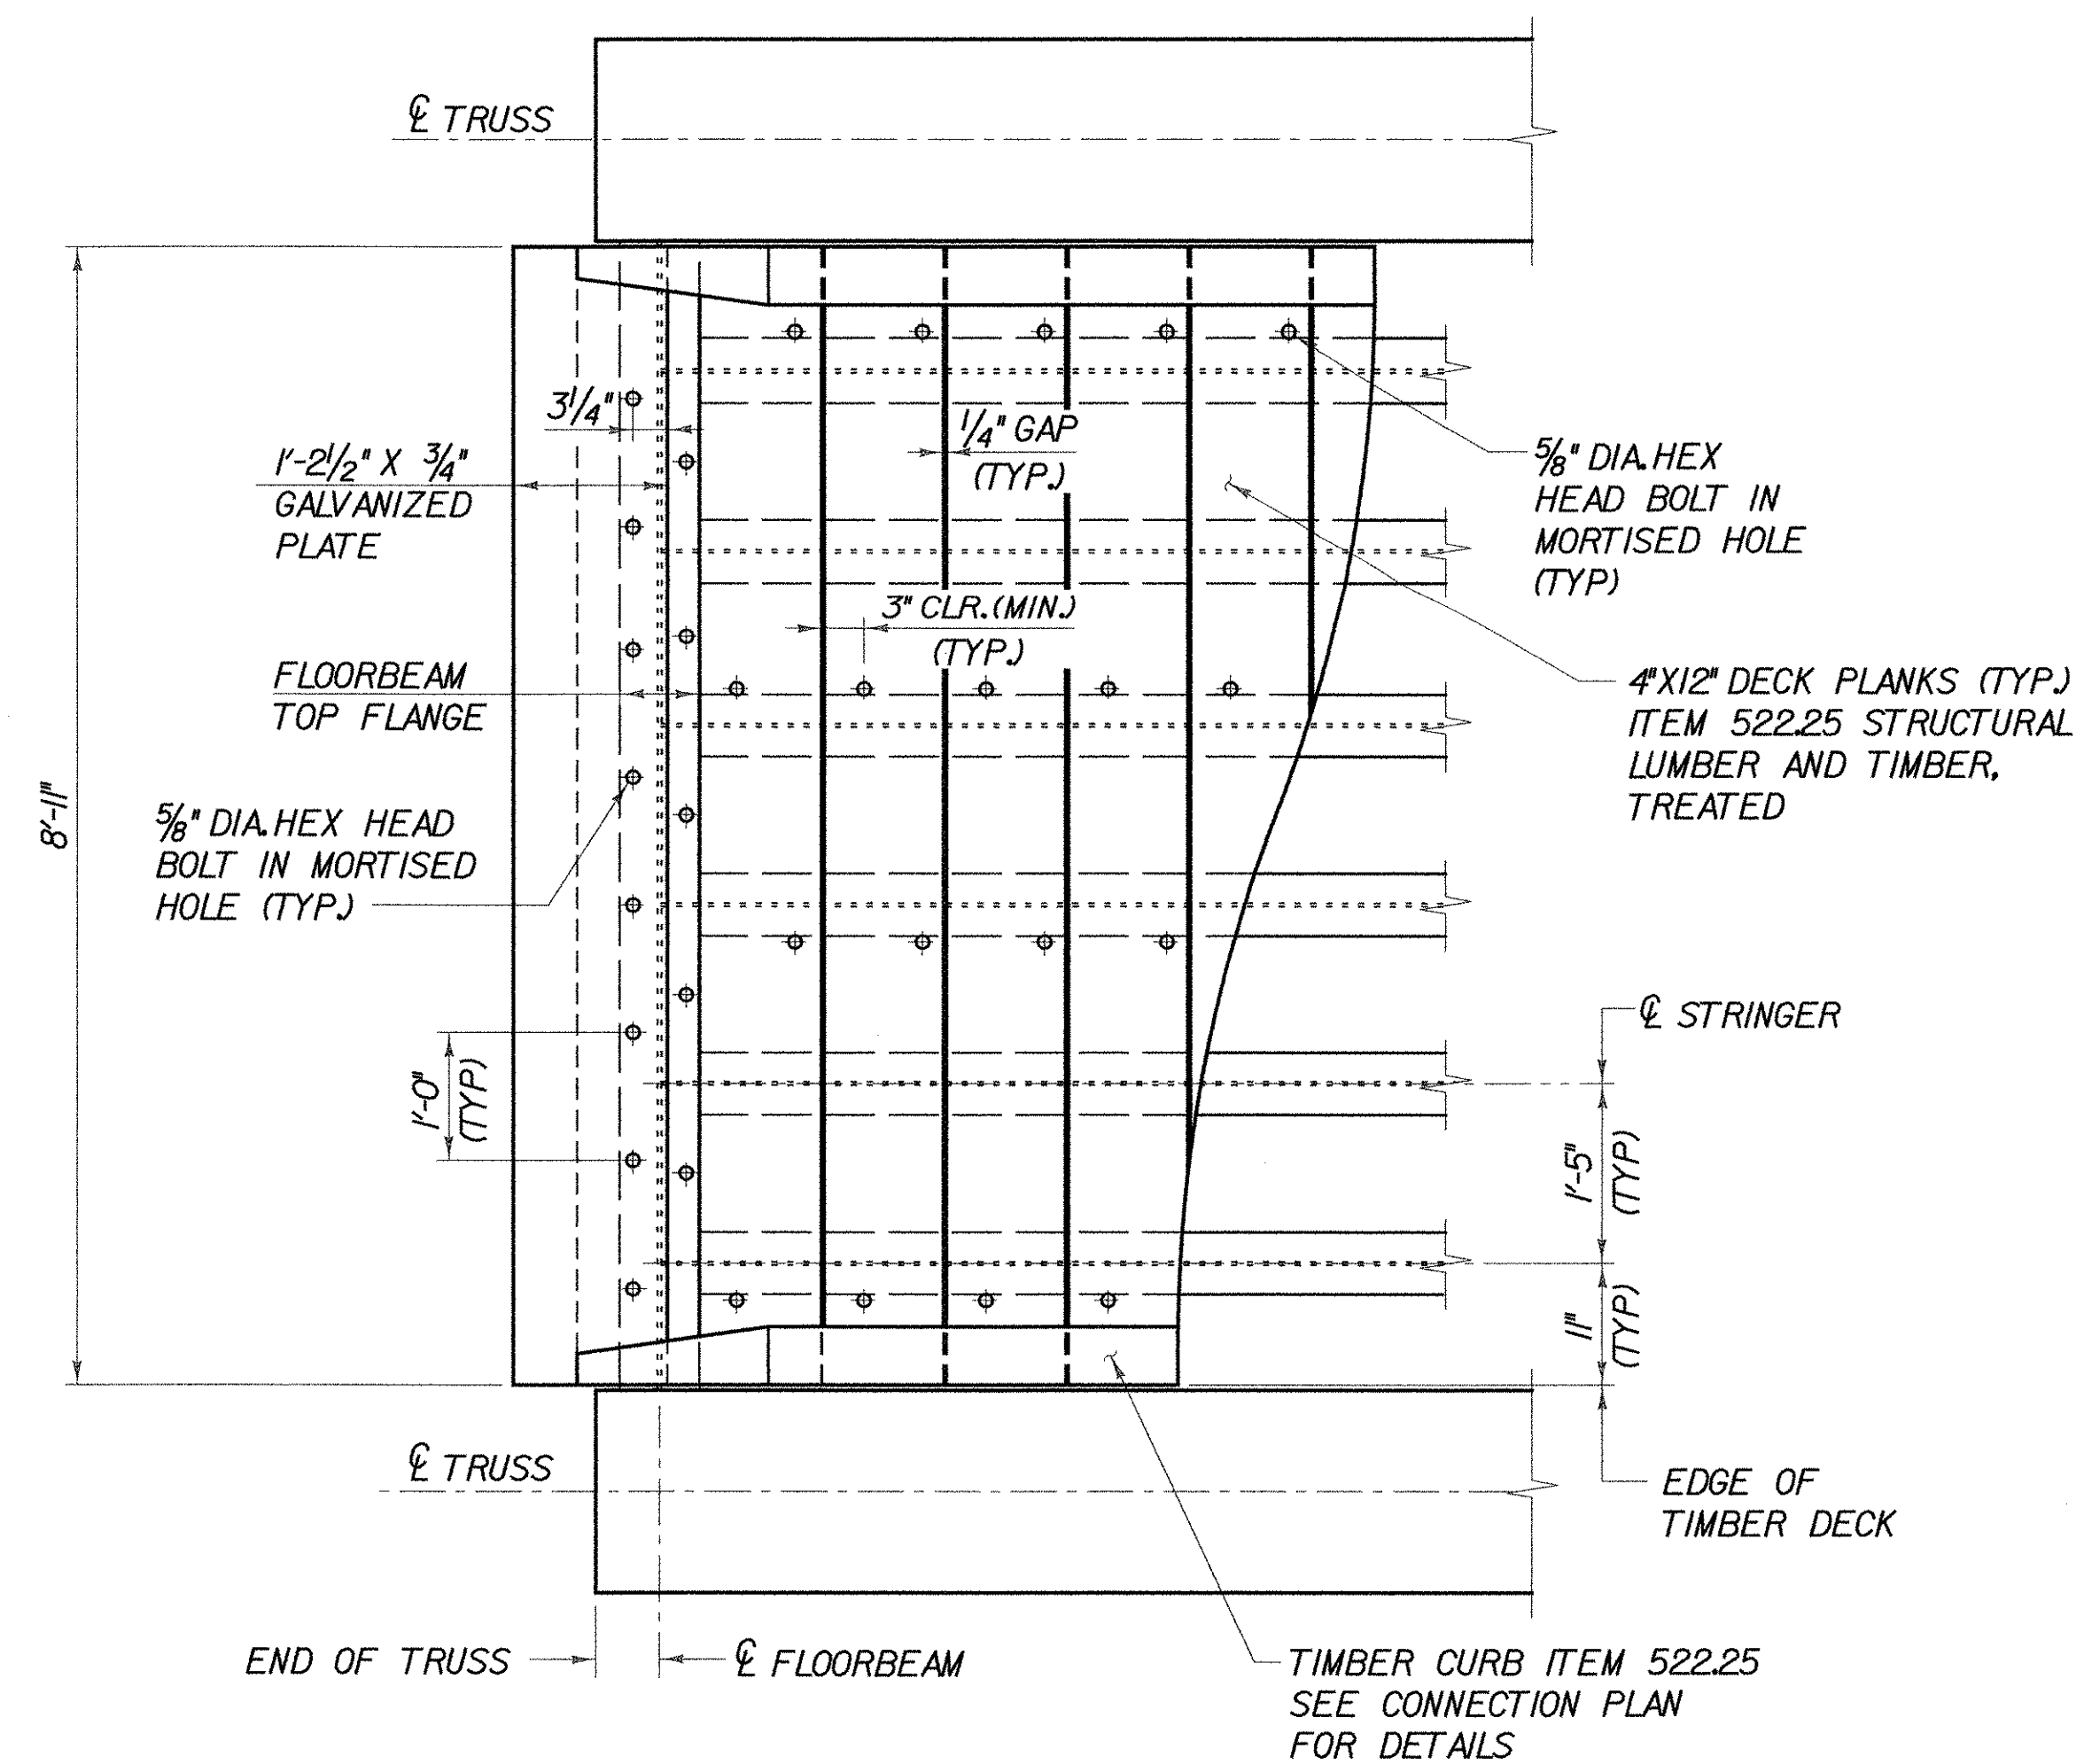

TIMBER DECK PARTIAL PLAN

SCALE $\frac{3}{4}" = 1'-0$

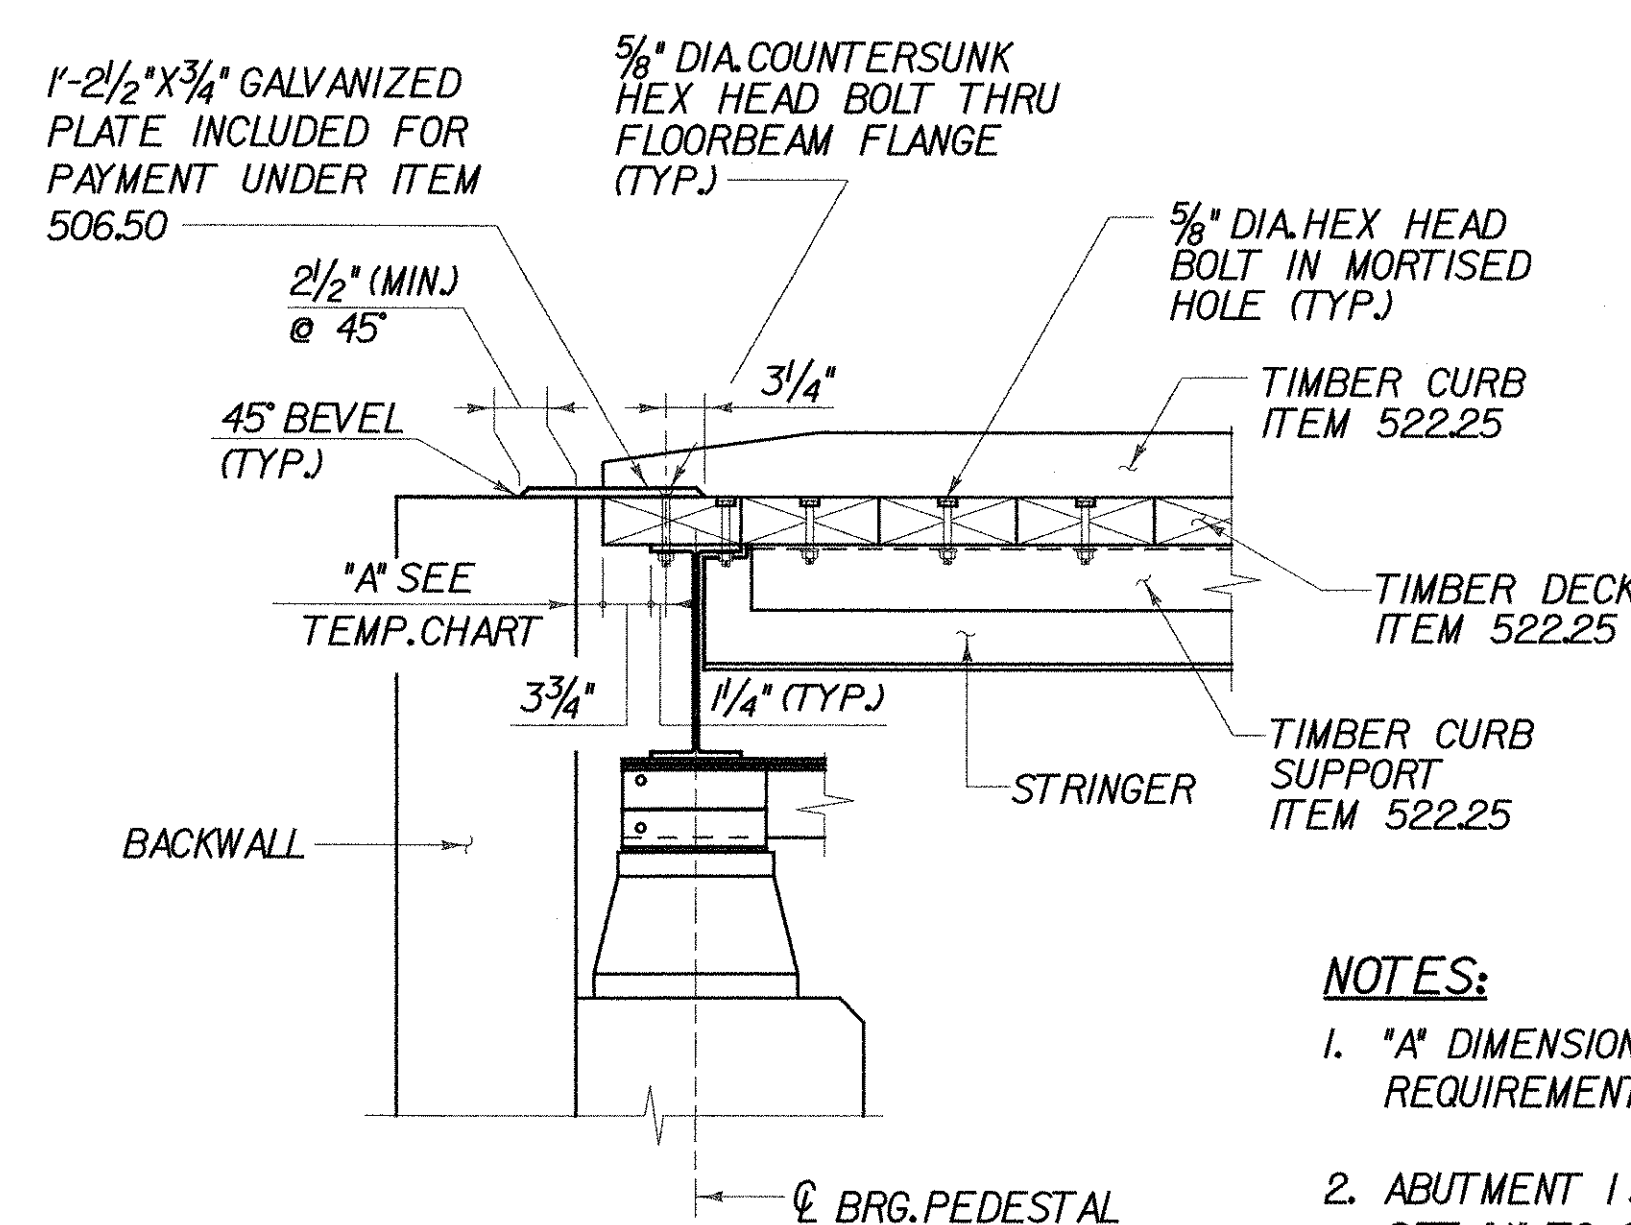


END JOINT DETAIL

SCALE $\frac{3}{4}" = 1'-0"$


TEMP. CHART	
TEMP.	"A"
0° F	2 ³ / ₄ "
15° F	2 ⁵ / ₈ "
30° F	2 ¹ / ₂ "
45° F	2 ¹ / ₄ "
60° F	2 ¹ / ₈ "
75° F	2"
90° F	1 ⁷ / ₈ "
105° F	1 ³ / ₄ "

- NOTES:
1. "A" DIMENSIONS SHOWN IN TEMP. CHART ARE MINIMUM REQUIREMENTS AT ABUTMENT 1.
 2. ABUTMENT 1 SHOWN, ABUTMENT 2 SIMILAR. AT ABUTMENT 2 SET "A" TO 2 1/4" REGARDLESS OF AMBIENT TEMPERATURE.

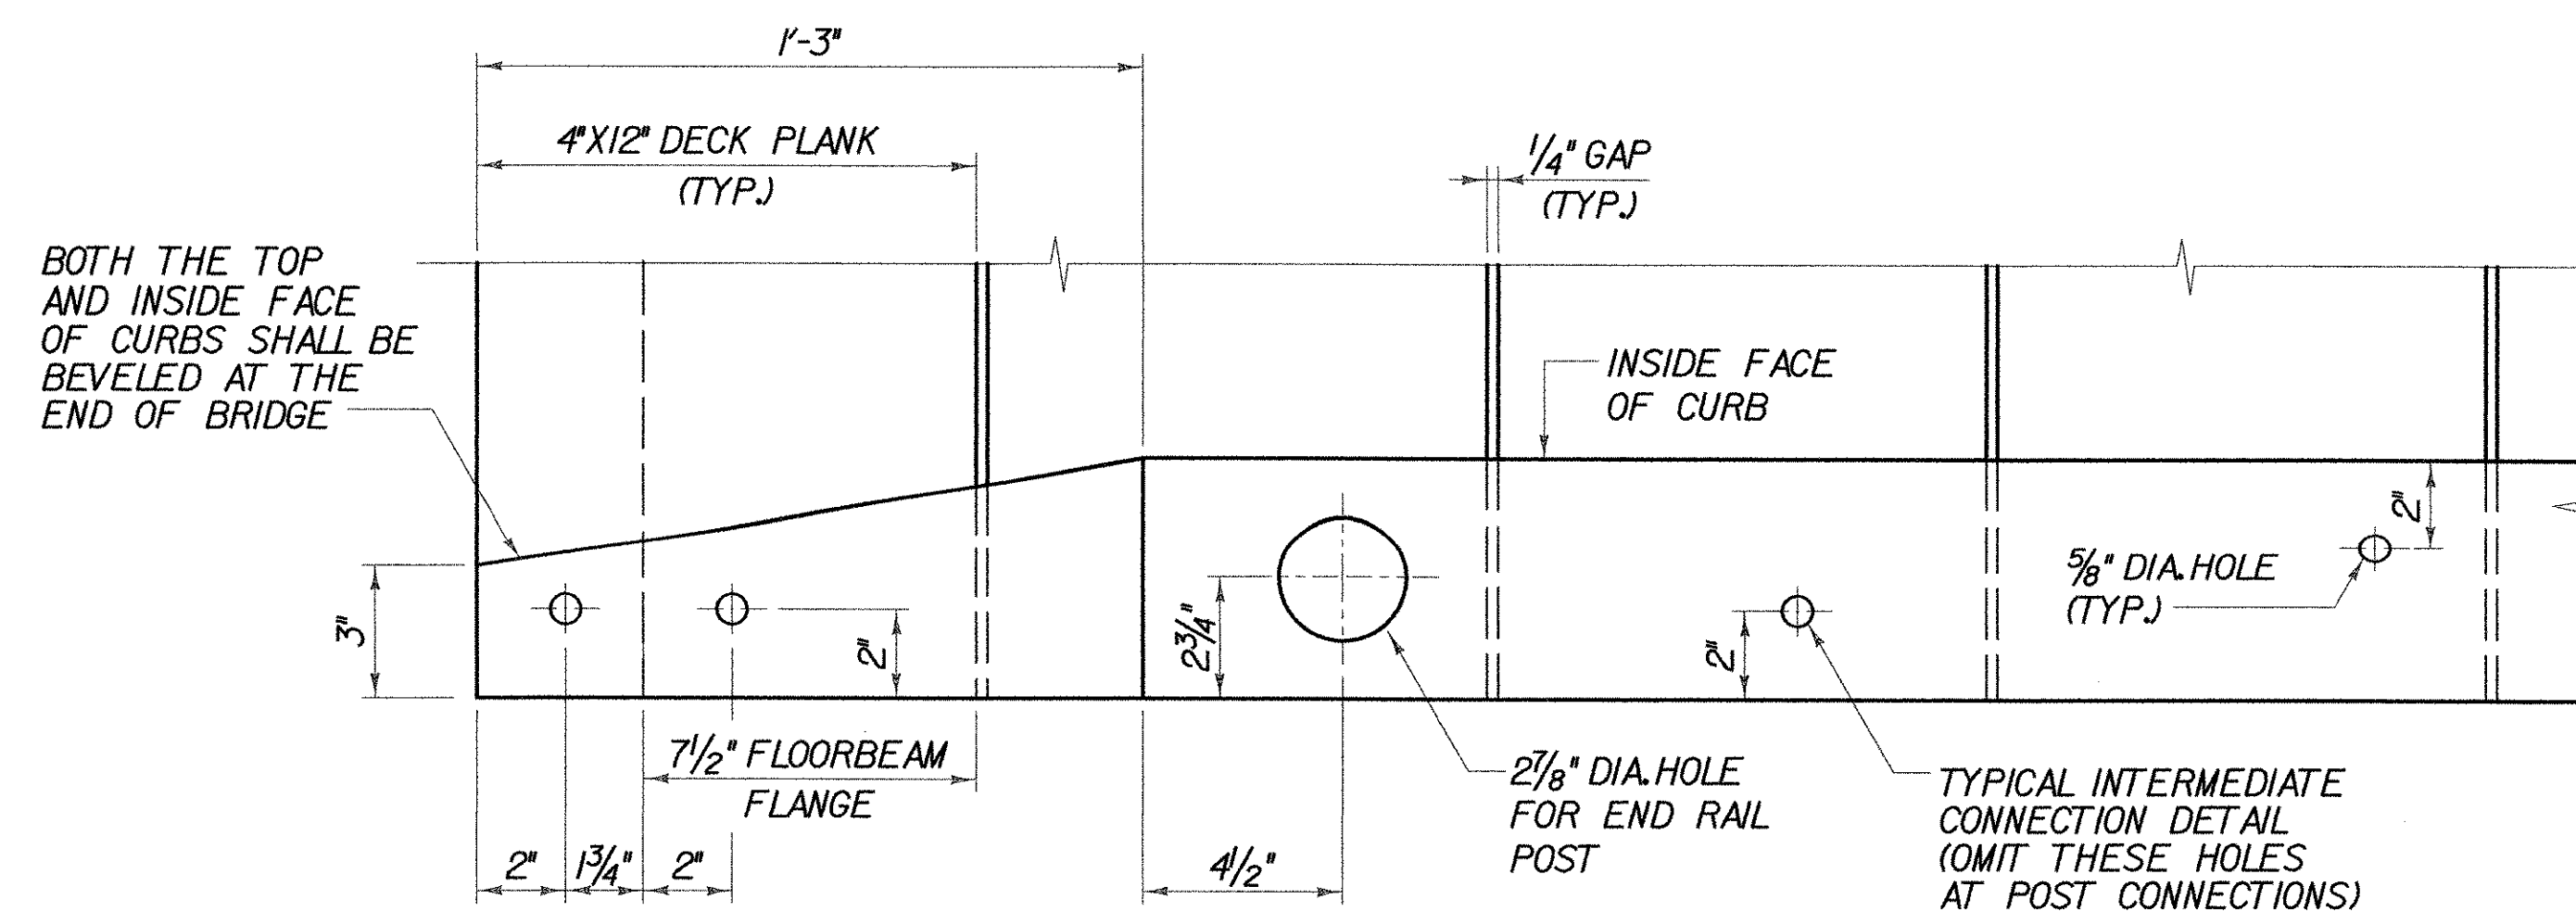


CURB CONNECTION PLAN

SCALE 3" = 1'-0"

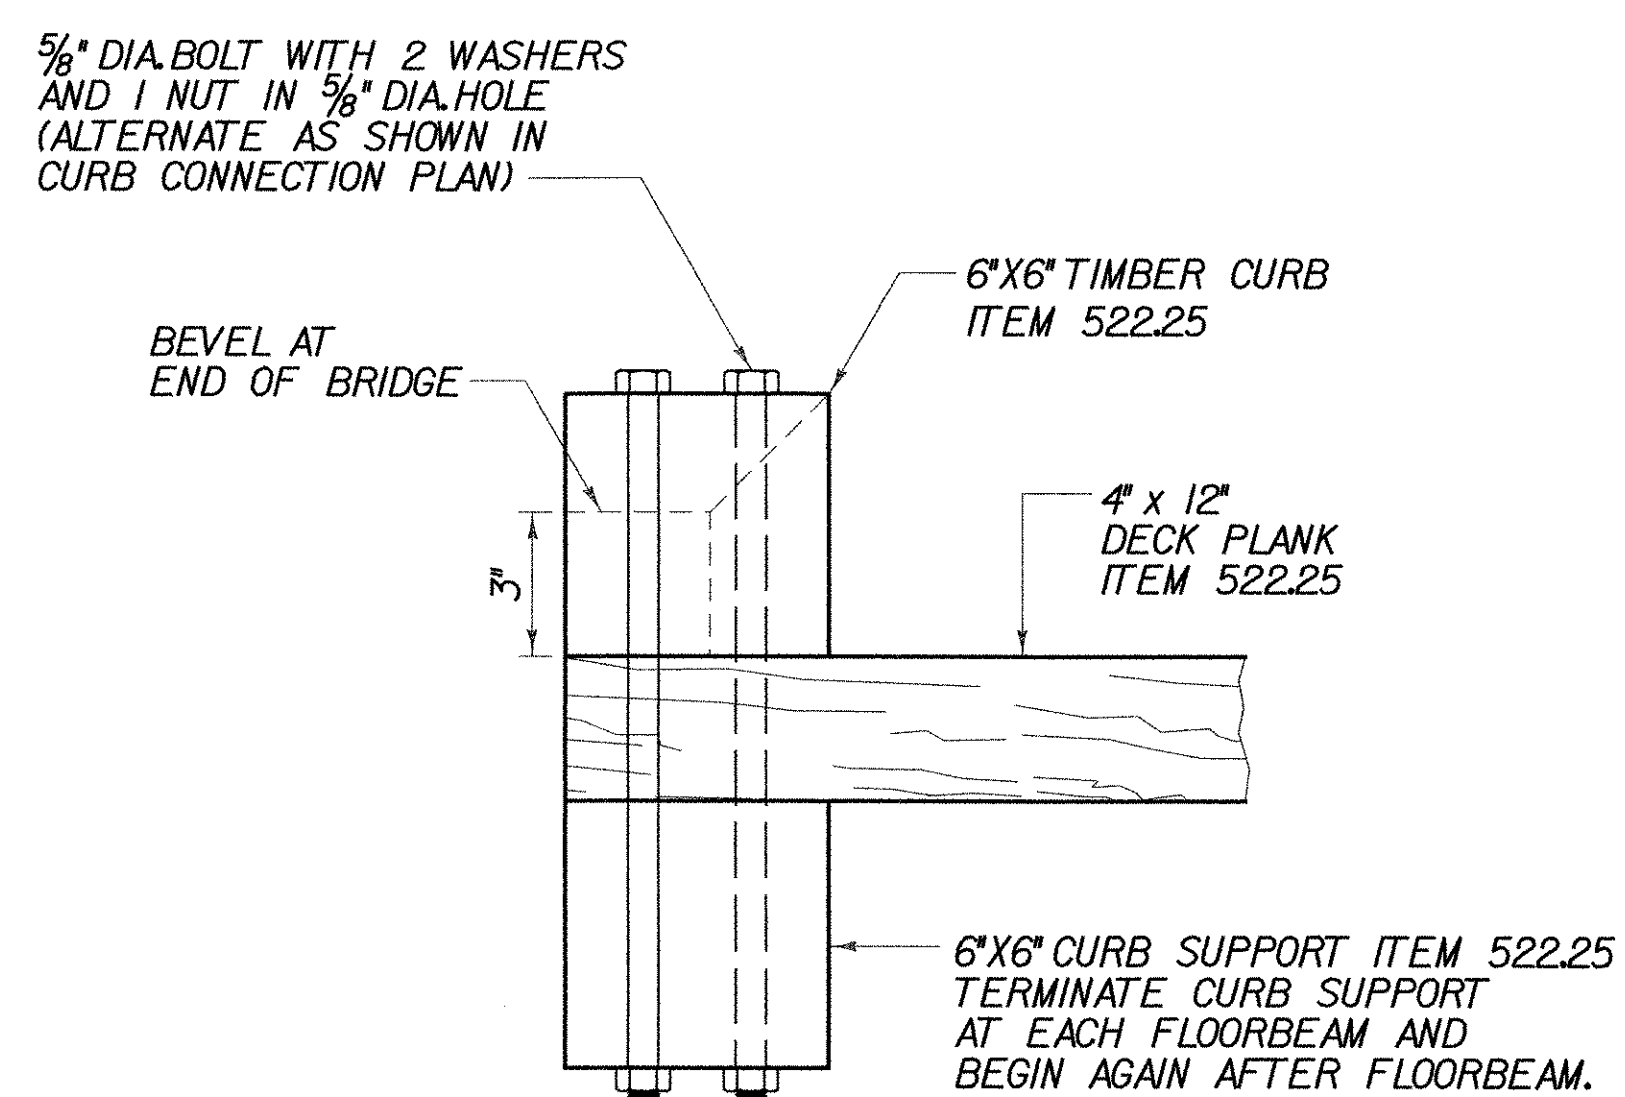

TYPICAL CURB SECTION

SCALE 3" = 1'-0"

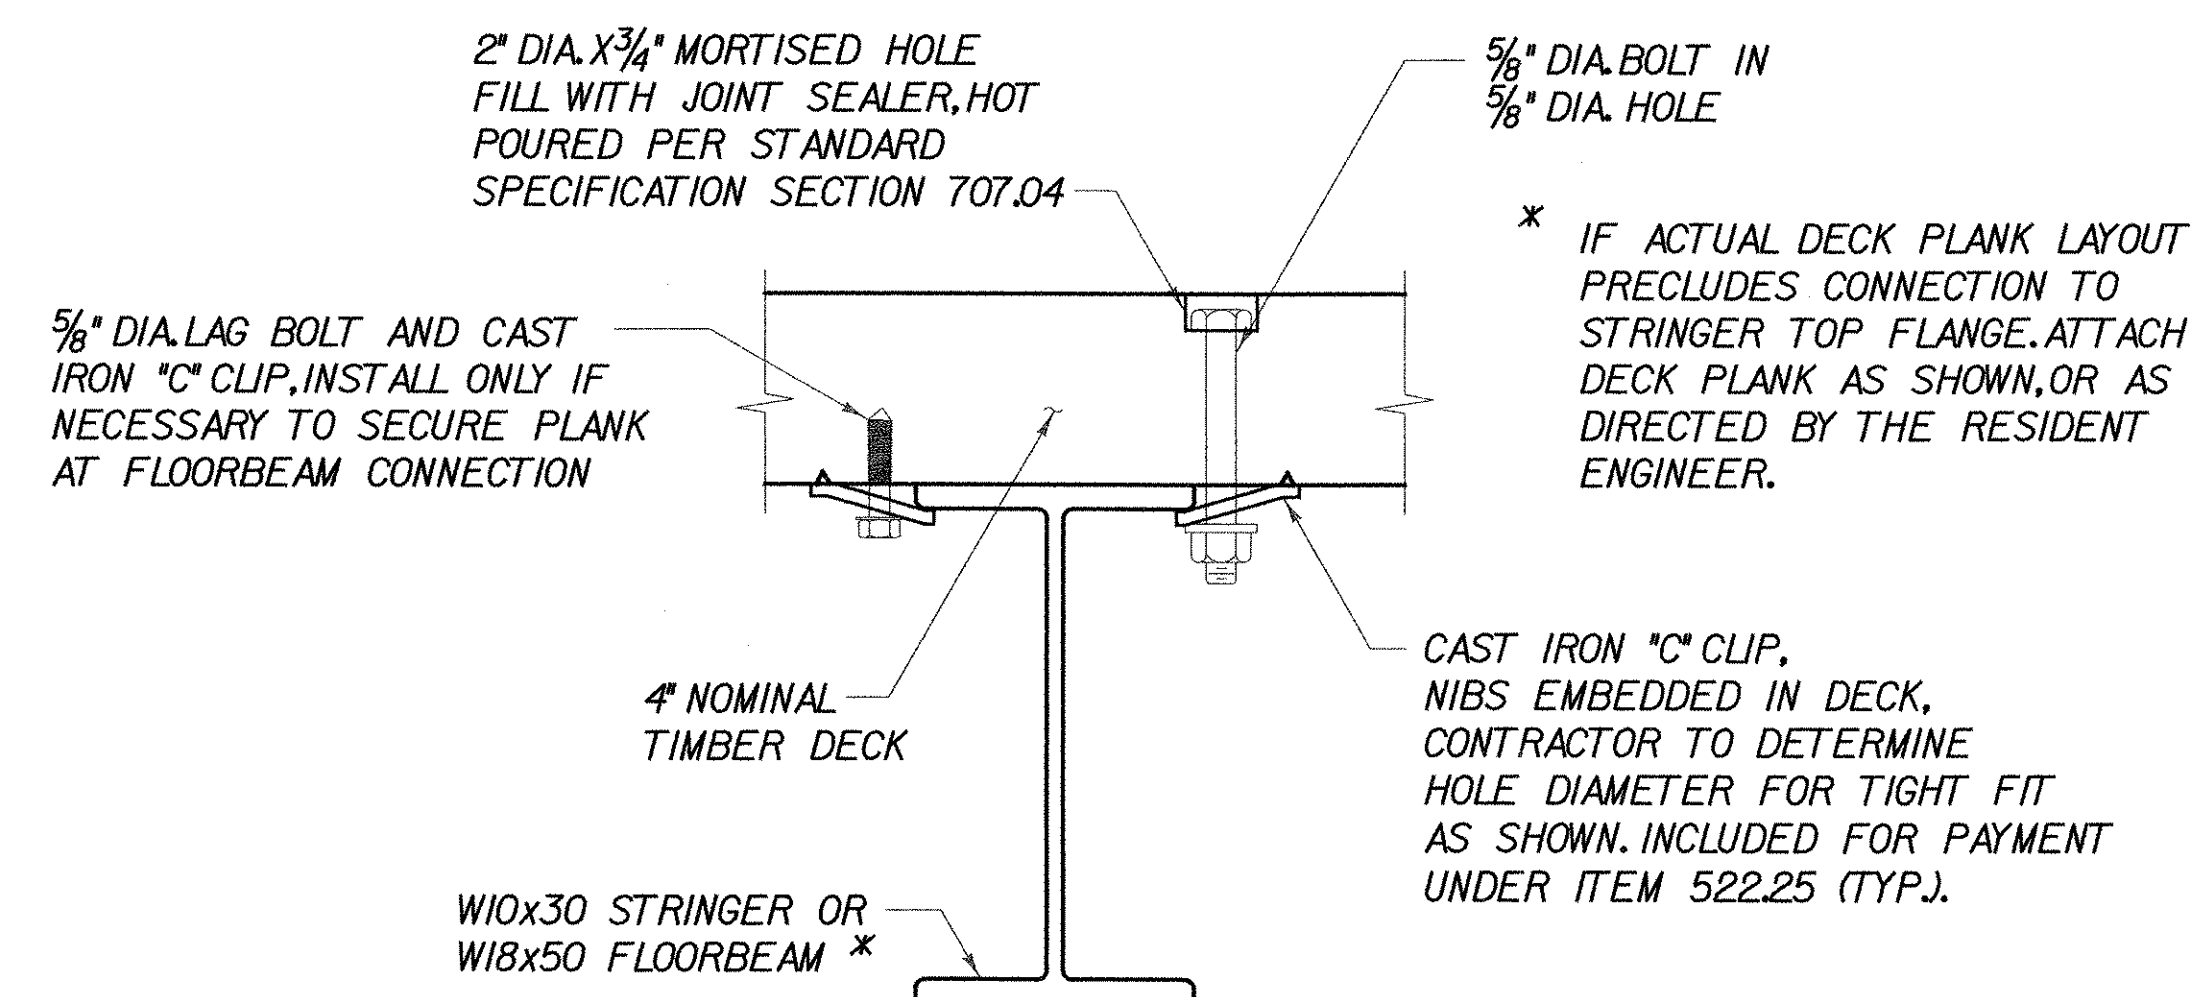

DECK CONNECTION DETAIL

SCALE 3" = 1'-0"

DECK PLAN AND DETAILS

PROJECT NAME: WALLINGFORD
PROJECT NUMBER: STP ST WALK(14)

FILE NAME: \$FILES\$
PROJECT MANAGER: SUSAN SCRIBNER
DESIGNED BY: L. HARDEN
BRIDGE DESIGN SUPERVISOR: P. HALSTEAD

FILE NAME: \$FILES\$	PLOT DATE: 1/9/2009
PROJECT MANAGER: SUSAN SCRIBNER	DRAWN BY: W. WEATHERBY
DESIGNED BY: L. HARDEN	CHECKED BY: P. HALSTEAD
BRIDGE DESIGN SUPERVISOR: P. HALSTEAD	SHEET 17 OF 26

PLOT DATE: 1/9/2009
DRAWN BY: W. WEATHERBY
CHECKED BY: P. HALSTEAD
SHEET 17 OF 26

PROJECT MANAGER: SUSAN SCRIBNER

DRAWN BY: W. WEATHERBY

DESIGNED BY: L. HARDEN

CHECKED BY: P. HALSTEAD

BRIDGE DESIGN SUPERVISOR: P. HALSTEAD

SHEET 17 OF 26

CHA